

MISSISSIPPI DEPARTMENT OF NATURAL RESOURCES

Bureau of Land and Water Resources

Southport Mall

P.O. Box 10631

Jackson, Mississippi 39209

WATER WELL DRILLERS LOG

Permit Applied For  
K 59

5-8 1988 Dyer Well Leflore  
date well completed firm name county well located

LANDOWNER: Leflore Co. School  
Leflore Court House  
Greenwood Ms 38930  
(mailing address)

description of formations encountered	from	to
Clay	0	34
Fine Sand	34	45
Fine Sand & Clay	45	56
M-Sand	56	68
Fine Sand	68	84
Fine Sand & Gravel	84	86
Sand & Gravel	86	126

WELL LOCATION:  
sec 16 T 19 N R 1 E  
2 miles NE of Dyer  
(distance) (direction) (nearest town)

WELL PURPOSE: Sampling  
(home, irrigation, municipal, industrial)

WELL COMPLETION DATA:

(1) diameter (inches) 12"

(2) total depth (feet) 126'

(3) static water level (feet) \_\_\_\_\_ below above top of ground.

(4) casing steel (material) (depth) \_\_\_\_\_  
12" If telescope see back.  
(size)

(5) screen 40' (length) (depth to top) \_\_\_\_\_  
12" (size) (material)

(6) pump 60 (HP) (yield gpm) \_\_\_\_\_  
Gear (type power)

(7) electric log No (yes or no)  
None (organization running log)

(8) how well bottom plugged Plate

RECEIVED


JUN 06 1988

Department of Natural Resources  
Bureau of Land & Water Resources

DRILLERS REMARKS:

If well telescopes please sketch and show depths.

GROUND LEVEL

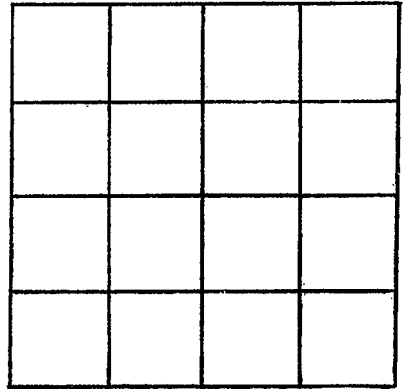

SECTION \_\_\_\_\_

Please indicate well location X.

ADDITIONAL INFORMATION

If more than one screen,  
show locations of each on sketch.