

MISSISSIPPI DEPARTMENT OF NATURAL RESOURCES

Bureau of Land and Water Resources

Southport Mall

P.O. Box 10631

CODED

Jackson, Mississippi 39209

WATER WELL DRILLERS LOG

BUTANE GAS CO. OF GREENWOOD

POST OFFICE BOX 1135

GREENWOOD MISSISSIPPI

*Leflore*  
*R 64*

*Feb. 1* 19 *82*  
date well completed

firm name

county well located

LANDOWNER:	description of formations encountered	from	to
<i>Marge Hayden</i>			
<i>Alta Bena</i>	<i>shale</i>	<i>40</i>	<i>55</i>
(mailing address)	<i>Sand + gravel</i>	<i>55</i>	<i>108</i>
WELL LOCATION:			
sec. <i>18</i> T <i>19</i> N <i>5</i> W R <i>1</i> E W			
<i>2</i> miles <i>SW</i> of <i>Alta Bena</i>			
(distance) (direction) of (nearest town)			
WELL PURPOSE: <i>Irrigation</i>			
(home, irrigation, municipal, industrial)			
WELL COMPLETION DATA:			
(1) diameter (inches) <i>16"</i>			
(2) total depth (feet) <i>108</i>			
(3) static water level (feet) <i>30</i> below above top of ground.			
(4) casing <i>Steel, 68'</i>			
(material) (depth)			
<i>16"</i> If telescope see back.			
(size)			
(5) screen <i>40' 68'</i>			
(length) (depth to top)			
<i>16 Steel</i>			
(size) (material)			
(6) pump <i>60 2500</i>			
(HP) (yield gpm)			
<i>Diesel</i>			
(type power)			
(7) electric log <i>No</i>			
(yes or no)			
<i>No</i>			
(organization running log)			
(8) how well bottom plugged <i>Steel plates</i>			

DEPT. OF NATURAL RESOURCES  
BUREAU OF LAND & WATER RESOURCES

MAR - 3 1982


RECEIVED

DRILLERS REMARKS:

*Just*

If well telescopes please sketch and show depths.

GROUND LEVEL

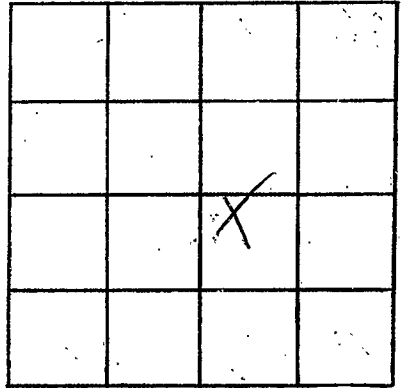

SECTION 18

Please indicate well location X.

ADDITIONAL INFORMATION

If more than one screen, show locations of each on sketch.