

MISSISSIPPI DEPARTMENT OF NATURAL RESOURCES

Bureau of Land and Water Resources

Southport Mall

P.O. Box 10631

Jackson, Mississippi 39209

WATER WELL DRILLERS LOG

CODED

BUTANE GAS CO. OF GREENWOOD

POST OFFICE BOX 1125

GREENWOOD, MISS. 38931 county well located

Leflore
K 65

3-20 19 82
date well completed

Leflore

LANDOWNER:	description of formations encountered	from	to
<i>Green River</i>	<i>clay</i>	0	18
<i>Jimmy Green</i> (mailing address)	<i>sand + gravel</i>	18	60
WELL LOCATION: sec. <u>5</u> T. <u>19</u> N. R. <u>1 E.</u> <u>8</u> miles <u>W</u> of <u>Greenwood</u> (distance) (direction) (nearest town)			
WELL PURPOSE: <u>municipal</u> (home, irrigation, municipal, industrial)			
WELL COMPLETION DATA: (1) diameter (inches) <u>16"</u> (2) total depth (feet) <u>100'</u> (3) static water level (feet) <u>18</u> ^{below} _{above} top of ground. (4) casing <u>steel</u> , <u>60'</u> (material) (depth) <u>16"</u> if telescope see back. (size) (5) screen <u>40</u> , <u>60'</u> (length) (depth to top) <u>16</u> , <u>steel</u> (size) (material) (6) pump <u>80</u> , <u>1200</u> (HP) (yield gpm) <u>Diesel</u> (type power) (7) electric log <u>NO</u> (yes or no) <u>NO</u> (organization running log) (8) how well bottom plugged: <u>steel plate</u>			

DEPT. OF NATURAL RESOURCES
BUREAU OF LAND & WATER RESOURCES


MAR 29 1982

RECEIVED

DRILLERS REMARKS:
Carlos Ramon

If well telescopes please sketch and show depths.

GROUND LEVEL

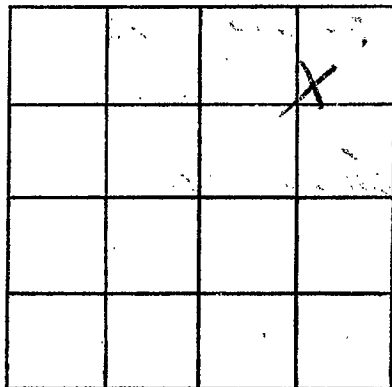

SECTION 5

Please indicate well location X.

ADDITIONAL INFORMATION

If more than one screen,
show locations of each on sketch.