

MISSISSIPPI DEPARTMENT OF NATURAL RESOURCES

Bureau of Land and Water Resources

Southport Mall

P.O. Box 10631

Jackson, Mississippi 39209

WATER WELL DRILLERS LOG

LEFLORE
K 67
12/15/83

CODED

12/15 1983 J+K Irrigation Leflore
date well completed firm name county well located

LANDOWNER: <u>Shirwood Strain</u>	description of formations encountered	from	to
<u>Atta Bena</u> (mailing address)	<u>CLAY</u>	<u>0</u>	<u>22</u>
	<u>Fine Sand</u>	<u>22</u>	<u>41</u>
	<u>Sand Gravel</u>	<u>41</u>	<u>113</u>

WELL LOCATION:
sec. 6 T. 19 N. R. 2 E
3 miles W of Atta Bena
(distance) (direction) (nearest town)

WELL PURPOSE:
(home, irrigation, municipal, industrial)

- WELL COMPLETION DATA:
- (1) diameter (inches) 16"
 - (2) total depth (feet) 113
 - (3) static water level (feet) 31 below above top of ground.
 - (4) casing steel, 73 (material), (depth)
 - 16 (size) if telescope see back.
 - (5) screen 40, 73' (length), (depth to top)
 - 16 (size), steel (material)
 - (6) pump 60 (HP), 2500 (yield gpm)
 - electric (type power)
 - (7) electric log NO (yes or no)

CODED	
DEPT. OF NATURAL RESOURCES BUREAU OF LAND & WATER RESOURCES	
DEC 20 1983	
RECEIVED	


(organization running log)

(8) how well bottom plugged plate

DRILLERS REMARKS:

If well telescopes please sketch and show depths.

GROUND LEVEL

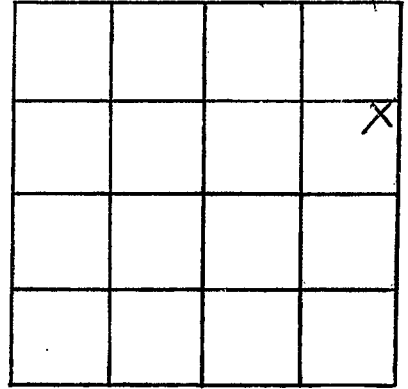

SECTION 6

Please indicate well location X.

ADDITIONAL INFORMATION

If more than one screen,
show locations of each on sketch.