

MISSISSIPPI DEPARTMENT OF NATURAL RESOURCES
Bureau of Land and Water Resources
 Southport Mall
 P.O. Box 10631 **CODED**
 Jackson, Mississippi 39209
WATER WELL DRILLERS LOG

K69
LEFLORE
12-19-84

12-19-84 ¹⁹ Rayborn Drilling LeFlore
 date well completed firm name county well located

LANDOWNER: David New
Drilling Co., P.O. Box 1487,
Natchez, MS 39120
 (mailing address)

description of formations encountered	from	to
<u>Gumbo</u>	<u>0</u>	<u>25</u>
<u>Sand</u>	<u>26</u>	<u>90</u>

WELL LOCATION:
 sec 22 T 19 N S R 1 E W
6 miles E of Greenwood
 (distance) (direction) (nearest town)

WELL PURPOSE: oil field
 (home, irrigation, municipal, industrial)

- WELL COMPLETION DATA:**
- (1) diameter (inches) 3"
 - (2) total depth (feet) 90'
 - (3) static water level (feet) 20' ^(below) above top of ground.
 - (4) casing blk pipe 70'
 (material) (depth)
3" if telescope see back.
 (size)
 - (5) screen 20' 70'
 (length) (depth to top)
3" slotted pipe
 (size) (material)
 - (6) pump — 50
 (HP) (yield gpm)
 (type power)
 - (7) electric log no
 (yes or no)
 (organization running log)
 - (8) how well bottom plugged wood

beaso memo
Metcalf 1-22
330' S - 330' E of NW/COE
NW SE


RECORDED
INDEXED
 OCT - 8 1984

DRILLERS REMARKS:

Department of Natural Resources
 Bureau of Land & Water Resources

If well telescopes please
sketch and show depths.

GROUND LEVEL

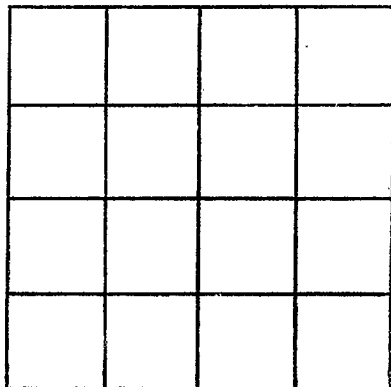

SECTION _____

Please indicate well location X.

ADDITIONAL INFORMATION

If more than one screen,
show locations of each on sketch.