

MISSISSIPPI DEPARTMENT OF NATURAL RESOURCES

Bureau of Land and Water Resources

Southport Mall

P.O. Box 10631

Jackson, Mississippi 39209

WATER WELL DRILLERS LOG

II  
CODED

LEFLORE  
K 71

5/21 1986  
date well completed

J & K Irrigation  
firm name

LeFlore  
county well located

LANDOWNER: Cecil Rushlow

description of formations encountered

from

to

CLAY

0 24

(mailing address)

FINE SAND

24 36

WELL LOCATION:

sec I T 19 N R I  
3 1/2 miles N W of Greenwood  
(distance) (direction) (nearest town)

SAND Gravel

36 107

WELL PURPOSE:

(home, irrigation, municipal, industrial)

WELL COMPLETION DATA:

- (1) diameter (inches) 16
- (2) total depth (feet) 167
- (3) static water level (feet) 18 below top of ground.
- (4) casing Steel 77 (material), (depth), 16 (size) if telescope see back.
- (5) screen 40 (length), 77 (depth to top), 16 (size), Steel (material)
- (6) pump 110 (HP), 1800 (yield gpm), Diesel (type power)
- (7) electric log NO (yes or no)

(organization running log)

(8) how well bottom plugged Plate

DRILLERS REMARKS:

CODED

RECEIVED  
MAY 9 1986


Department of Natural Resources  
Bureau of Land & Water Resources

If well telescopes please sketch and show depths.

GROUND LEVEL

A large vertical rectangular area for sketching well telescopes, bounded on the left by a vertical line and on the top by a horizontal line labeled 'GROUND LEVEL'.

If more than one screen, show locations of each on sketch.

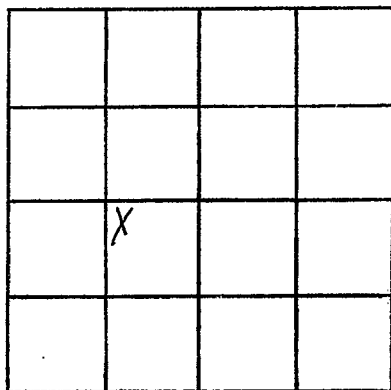

SECTION \_\_\_\_\_

Please indicate well location X.

ADDITIONAL INFORMATION

A series of horizontal lines for entering additional information.