

MISSISSIPPI DEPARTMENT OF NATURAL RESOURCES

Bureau of Land and Water Resources

Southport Mall

P.O. Box 10631

Jackson, Mississippi 39209

WATER WELL DRILLERS LOG

III
CODED

LeFlore
K 72

5/23

1984 J & K INVESTIGATION

LeFlore

date well completed

firm name

county well located

LANDOWNER: Cecil Rushing

description of formations encountered

from

to

CLAY

0

24

(mailing address)

FINE SAND

11

34

WELL LOCATION:

sec. 5 T. 19 N R. I W
4 miles N of ITTA BENA
(distance) (direction) (nearest town)

SAND Gravel

34

107

WELL PURPOSE:

(home, irrigation, municipal, industrial)

WELL COMPLETION DATA:


- (1) diameter (inches) 16
- (2) total depth (feet) 107
- (3) static water level (feet) 21 below above top of ground.
- (4) casing Steel, 27
(material) (depth)
16 if telescope see back.
(size)
- (5) screen 40, 77
(length) (depth to top)
16 (size) (material)
- (6) pump 80, 1000
(HP) (yield gpm)
Disiel
(type power)
- (7) electric log NO
(yes or no)

(organization running log)

(8) how well bottom plugged PLATE

DRILLERS REMARKS:


CODED

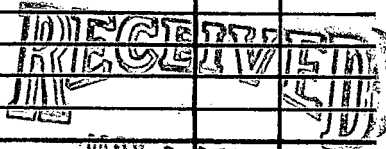

Department of Natural Resources
Bureau of Land and Water Resources

If well telescopes please sketch and show depths.

GROUND LEVEL

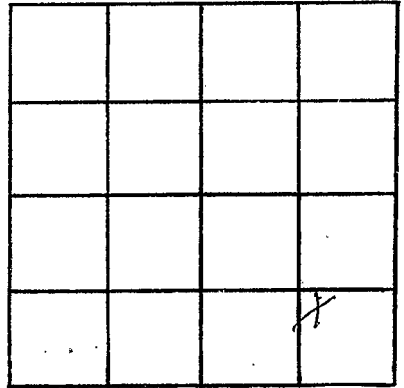

SECTION 3

Please indicate well location X.

ADDITIONAL INFORMATION

If more than one screen,
show locations of each on sketch.