

LEFLORE
K 73

MISSISSIPPI DEPARTMENT OF NATURAL RESOURCES
Bureau of Land and Water Resources
Southport Mall
P.O. Box 10631
Jackson, Mississippi 39209
WATER WELL DRILLERS LOG

CODED

7-10-86
date well completed

BUTANE GAS CO. OF GREENWOOD
BUTANE GAS CO. OF GREENWOOD
firm name

Leflore
county well located

LANDOWNER:
Fort Loring Plantation
Greenwood, Miss
(mailing address)


description of formations encountered	from	to
Clay	0	18
Fine Sand	18	40
Coarse Sand	40	70
Gravel	70	105

WELL LOCATION:
sec. 23 T 19 N R 1 E S 1 W
1 1/2 miles S.W. of Fort Loring
(distance) (direction) (nearest town)

WELL PURPOSE: For
(home, irrigation, municipal, industrial)

- WELL COMPLETION DATA:
- (1) diameter (inches) 16
 - (2) total depth (feet) 105
 - (3) static water level (feet) 20 below above top of ground.
 - (4) casing Steel, 6.5' (material) (depth)
16" if telescope see back. (size)
 - (5) screen 40' 65' (length) (depth to top)
16" Steel (size) (material)
 - (6) pump 60 1800 (HP) (yield gpm)
Diesel (type power)
 - (7) electric log No (yes or no)
(organization running log)
 - (8) how well bottom plugged Steel Plate

CODED

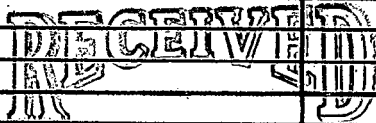


AUG 12 1986

Department of Natural Resources
Bureau of Land & Water Resources

DRILLERS REMARKS:

If well telescopes please sketch and show depths.

GROUND LEVEL

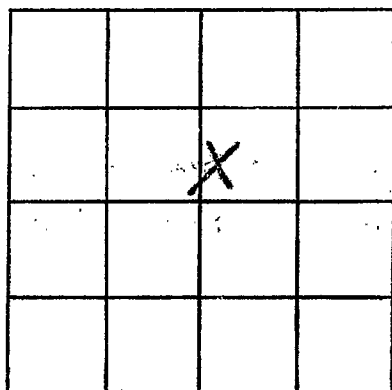

SECTION 23

Please indicate well location X.

ADDITIONAL INFORMATION

If more than one screen,
show locations of each on sketch.