

MISSISSIPPI DEPARTMENT OF NATURAL RESOURCES

Bureau of Land and Water Resources

Southport Mall

P.O. Box 10631

Jackson, Mississippi 39209

WATER WELL DRILLERS LOG

LeFlora  
K 74  
148 B

Cased

7-21 1987  
 date well completed

J-K Irrigation  
 firm name

LeFlora  
 county well located

LANDOWNER: Gerald Conway

Greenwood, Miss.

(mailing address)

WELL LOCATION:

sec. 26 T. 19 N. R. 1 W  
4 miles SW of Greenwood  
 (distance) (direction) (nearest town)

WELL PURPOSE: Irrigation  
 (home, irrigation, municipal, industrial)

WELL COMPLETION DATA:

- (1) diameter (inches) 12"
- (2) total depth (feet) 109
- (3) static water level (feet) 19 below above top of ground.
- (4) casing Steel 79  
 (material) (depth)
- 12" If telescope see back.  
 (size)
- (5) screen 40' 79  
 (length) (depth to top)
- 12" Steel  
 (size) (material)
- (6) pump 80 1500  
 (HP) (yield gpm)
- Diesel  
 (type power)
- (7) electric log NO  
 (yes or no)

(organization running log)

(8) how well bottom plugged Plate

description of formations encountered

from

to

<u>Clay</u>	<u>0</u>	<u>12</u>
<u>Fine sand</u>	<u>12</u>	<u>39</u>
<u>C. Sand &amp; Gravel</u>	<u>39</u>	<u>109</u>

RECEIVED  
 NOV 12 1987


NOV 12 1987

Department of Natural Resources  
 Bureau of Land & Water Resources

DRILLERS REMARKS:

If well telescopes please sketch and show depths.

GROUND LEVEL

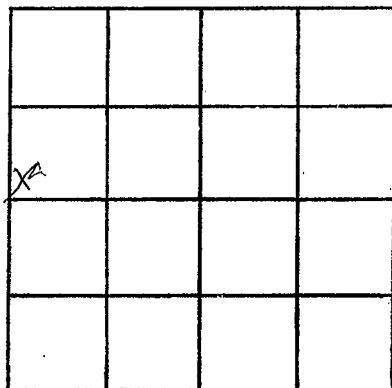

SECTION 26

Please indicate well location X.

ADDITIONAL INFORMATION

If more than one screen,  
show locations of each on sketch.