

MISSISSIPPI DEPARTMENT OF NATURAL RESOURCES

Bureau of Land and Water Resources

Southport Mall

P.O. Box 10631

Jackson, Mississippi 39209

WATER WELL DRILLERS LOG

<i>LeFlore</i>
<i>K 75</i>
<i>149 A</i>

Coded

7-28 19*57* *J & K Irrigation* *LeFlore*
 date well completed firm name county well located

LANDOWNER: *DWAYNE DUNK*
Greenwood, Miss
 (mailing address)

description of formations encountered	from	to
<i>CLAY</i>	<i>0</i>	<i>13</i>
<i>FINE SAND</i>	<i>13</i>	<i>31</i>
<i>C. SAND & GRAVEL</i>	<i>31</i>	<i>114</i>

WELL LOCATION:
 sec *36* T *19* N R *1* E
5 miles *SW* of *Greenwood*
 (distance) (direction) (nearest town)

WELL PURPOSE: *IRRIGATION*
 (home, irrigation, municipal, industrial)

- WELL COMPLETION DATA:
- (1) diameter (inches) *16"*
 - (2) total depth (feet) *114*
 - (3) static water level (feet) *18* below above top of ground.
 - (4) casing *Steel* *84*
 (material) (depth)
16" if telescope see back.
 (size)
 - (5) screen *40* *84*
 (length) (depth to top)
16" *Steel*
 (size) (material)
 - (6) pump *125* *1800*
 (HP) (yield gpm)
Disiet
 (type power)
 - (7) electric log *NO*
 (yes or no)
 (organization running log)
 - (8) how well bottom plugged *PLATE*

RECEIVED


NOV 12 1957

Department of Natural Resources
 Bureau of Land & Water Resources

DRILLERS REMARKS:

If well telescopes please sketch and show depths.

GROUND LEVEL

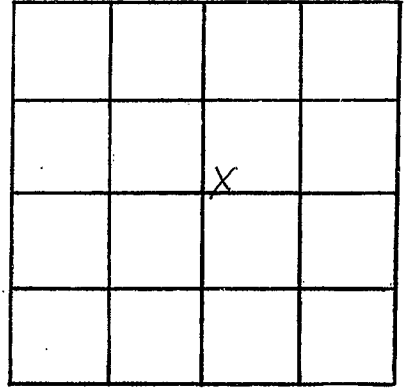

SECTION 36

Please indicate well location X.

ADDITIONAL INFORMATION

If more than one screen,
show locations of each on sketch.