

MISSISSIPPI DEPARTMENT OF NATURAL RESOURCES

Bureau of Land and Water Resources

COUNTY WELL LOCATED <i>LeFlore</i>	
WELL NUMBER <i>R 86</i>	CODED
DATE WELL COMPLETED <i>5-2-89</i>	

128D

PERMIT NUMBER
NAME OF DRILLING FIRM <i>J & K IRRIGATION</i>

CODED

P.O. Box 10631
Jackson, Mississippi 39209
WATER WELL DRILLERS LOG

NAME & MAILING ADDRESS OF LANDOWNER <i>Ray McKamsos</i> <i>Greenwood, ms</i>			
WELL LOCATION:	SEC <i>2</i>	TOWNSHIP <i>19 N</i>	RANGE <i>1 E</i>
DISTANCE <i>3</i> Miles	DIRECTION <i>E</i>	NEAREST TOWN <i>JITTA, Bern</i>	
OTHER LANDMARK			
WELL PURPOSE: Home, <u>Irrigation</u> , Municipal, Industrial, Fish Pond, etc.			

PUMP DATA			
PUMP TYPE (Circle One): Submersible, <u>Turbine</u> , Jet, Flowing Well, Other (Describe) _____			
POWER TYPE (Circle One): <u>Electric</u> , Tractor, Diesel, Gasoline, Butane, Other (Describe) _____			
Pump Capacity (GPM) <i>1500</i>	No. of Stages <i>2</i>	Setting Depth <i>50</i>	FT.
PUMP TEST			
Well yielded <i>1500</i> GPM with a drawdown of _____ ft. after _____ hours of pumping			

WELL DATA		
Well Depth <i>116</i>	Casing Diameter (In.) <i>16"</i>	Casing Length (Ft.) <i>96</i>
Type of Casing <i>Steel</i>	Hole Depth <i>116</i>	Depth to Static Water Level <i>29</i>
TYPE OF COMPLETION: (Circle One or More): <u>Gravel Packed</u> , Underreamed, Telescoped, Natural Development, Open Hole, Other (Describe) _____		
Top of Lap Pipe or Reduction in Casing FEET IF TELESCOPED OR MORE THAN ONE SCREEN: USE BACK PAGE		

LOG DATA	
TYPE OF LOG RUN (Circle One): Electric, Gamma Ray, Density, Sonic, <u>No Log Run</u> , Neutron, Other (Describe) _____	
Name of Organization Running Log	

SCREEN DATA		
Diameter - Inches <i>16</i>	Length - Feet <i>40</i>	Slot Size - Inches <i>.030</i>
Screen Type <i>Steel</i>	Depth to Bottom - Feet <i>116</i>	


GEOLOGIC DATA (Office Use Only)			
Surface Elev.	Geologic Unit	Unit Thickness	Depth to Top
Subs. SWL	Date	Analysis	Aquifer Test
Driller's Remarks			

RECEIVED

DESCRIPTION OF FORMATIONS ENCOUNTERED	FROM	TO	FORMATIONS (Continued)	FROM	TO
<i>CLAY</i>	<i>0</i>	<i>17</i>	<i>JUN 13 1989</i>		
<i>SAND</i>	<i>17</i>	<i>32</i>			
<i>SAND & GRAVEL</i>	<i>32</i>	<i>116</i>			
			Department of Natural Resources Bureau of Land & Water Resources		
IF MORE SPACE IS NEEDED, USE BACK					

If well telescopes please sketch and show depths.

GROUND LEVEL

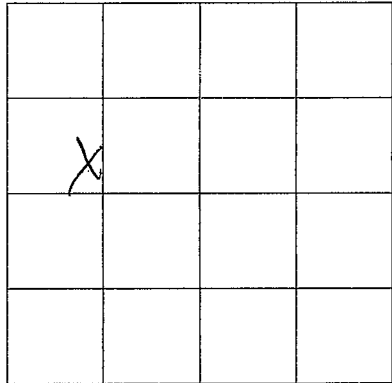

SECTION 2

Please indicate well location X.

ADDITIONAL INFORMATION

If more than one screen,
show location of each on sketch.