

MISSISSIPPI DEPARTMENT OF ENVIRONMENTAL QUALITY

Office of Land and Water Resources

P. O. Box 10631
Jackson, MS 39289-0631
WATER WELL DRILLERS LOG

COUNTY WELL LOCATED LeFlore	
WELL NUMBER R 87	CODED <input checked="" type="checkbox"/>
DATE WELL COMPLETED 2-28-95	

PERMIT NUMBER
NAME OF DRILLING FIRM CBS Drilling

NAME & MAILING ADDRESS OF LANDOWNER Viewsee UPchutch 116 Country club Dr. Greenwood, ms. 38930			
WELL LOCATION:	SEC 12	TOWNSHIP T19 N	RANGE R1 W
DISTANCE 4 Miles	DIRECTION SW	NEAREST TOWN of Greenwood	
OTHER LANDMARK			
WELL PURPOSE: <input checked="" type="radio"/> Home Irrigation, Municipal, Industrial, Fish Pond, etc.			

PUMP DATA		
PUMP TYPE (Circle One): <input checked="" type="radio"/> Submersible, Turbine, Jet, Flowing Well, Other (Describe) _____		
POWER TYPE (Circle One): <input checked="" type="radio"/> Electric, Tractor, Diesel, Gasoline, Butane, Other (Describe) _____ H/P _____		
Pump Capacity (GPM) 15	No. of Stages 9	Setting Depth 63 FT.
PUMP TEST		
Well yielded _____ GPM with a drawdown of _____ ft. after _____ hours of pumping		

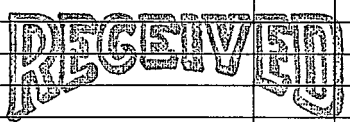
WELL DATA		
Well Depth 470	Casing Diameter (In.) 4	Casing Length (Ft.) 450
Type of Casing PVC	Hole Depth 489	Depth to Static Water Level 21

LOG DATA	
TYPE OF LOG RUN (Circle One): Electric, Gamma Ray, Density, Sonic, Neutron, Other (Describe) _____ <input checked="" type="radio"/> No Log Run.	
Name of Organization Running Log	

TYPE OF COMPLETION: (Circle One or More): <input checked="" type="radio"/> Gravel Packed, Underreamed, Telescoped, <input checked="" type="radio"/> Natural Development, Open Hole, Other	
WELL GROUTED TO A DEPTH OF 10 FEET Type Grout (circle one): <input checked="" type="radio"/> Cement, Bentonite, or Mix	

GEOLOGIC DATA (Office Use Only)			
Surface Elev.	Geologic Unit	Unit Thickness	Depth to Top
Subs. SWL	Date	Analysis	Aquifer Test
Driller's Remarks			

SCREEN DATA		
Diameter - Inches 4	Length - Feet 20	Slot Size - Inches .010
Screen Type		Depth to Bottom - Feet

DESCRIPTION OF FORMATIONS ENCOUNTERED	FROM	TO	FORMATIONS (Continued)	FROM	TO
TOP soil & clay	0	19	 MAR 03 1995 Dept. of Environmental Quality Office of Land & Water Resources		
SAND	19	21			
SAND & GRAVEL	21	128			
CLAY	128	176			
SAND	176	215			
Shell	215	368			
Shell & Rocks	368	426			
SAND	426	486			

IF MORE SPACE IS NEEDED, USE BACK

If well telescopes please sketch and show depths.

GROUND LEVEL

	X		

SECTION 12

Please indicate well location X.

ADDITIONAL INFORMATION

If more than one screen,
show location of each on sketch.