

MISSISSIPPI DEPARTMENT OF ENVIRONMENTAL QUALITY

Office of Land and Water Resources

P. O. Box 10631
Jackson, MS. 39289-0631
WATER WELL DRILLERS LOG

COUNTY WELL LOCATED LeFlore	
WELL NUMBER R 94	CODED <input checked="" type="checkbox"/>
DATE WELL COMPLETED 8-98	

PERMIT NUMBER
NAME OF DRILLING FIRM C & S Drilling

NAME & MAILING ADDRESS OF LANDOWNER TACKETT FARMS		
R.T. II, Box 128		
ITTA BENA, MS 38941		
WELL LOCATION: SEC	TOWNSHIP	RANGE
10	TA N	R 1 E
DISTANCE	DIRECTION	NEAREST TOWN
2 Miles	N	of ITTA BENA
OTHER LANDMARK 150' 4"		
WELL PURPOSE: Home, Irrigation, Municipal, Industrial, Fish Pond, etc. TENNANT HOUSE		

PUMP DATA		
PUMP TYPE (Circle One): <input checked="" type="radio"/> Submersible Turbine Jet Flowing Well, Other (Describe) _____		
POWER TYPE (Circle One): Electric, Tractor, Diesel, Gasoline, Butane, Other (Describe) _____ H/P _____		
Pump Capacity (GPM) 90	No. of Stages 12	Setting Depth 126 FT.
PUMP TEST		
Well yielded 90 GPM with a drawdown of _____ ft. after _____ hours of pumping		


WELL DATA		
Well Depth 1020	Casing Diameter (In.) 4" x 2 1/2"	Casing Length (Ft.) 980
Type of Casing Steel	Hole Depth 1030	Depth to Static Water Level 19
TYPE OF COMPLETION: (Circle One or More): Gravel Packed, Underreamed, Telescoped, <input checked="" type="radio"/> Natural Development, Open Hole, Other (Describe) _____		
WELL GROUTED TO A DEPTH OF 10 FEET Type Grout (circle one): Cement, Bentonite, or Mix		

LOG DATA	
TYPE OF LOG RUN (Circle One): No Log Run, Electric, Gamma Ray, Density, Sonic, Neutron, Other (Describe) _____	
Name of Organization Running Log	

SCREEN DATA		
Diameter - Inches 2 1/2	Length - Feet 40	Slot Size - Inches .010
Screen Type S.S.	Depth to Bottom - Feet 1020	

GEOLOGIC DATA (Office Use Only)			
Surface Elev.	Geologic Unit	Unit Thickness	Depth to Top
Subs. SWL	Date	Analysis	Aquifer Test
Driller's Remarks MORLIAN			


DESCRIPTION OF FORMATIONS ENCOUNTERED	FROM	TO
TOP Soil & Clay	0	22
SAND	22	58
SAND & GRAVEL	58	128
Clay	128	224
SAND & clay	224	344
SAND	344	402
Shale & Rocks	402	510
SAND & Rocks	510	640
Shale	640	938
SAND	938	1030

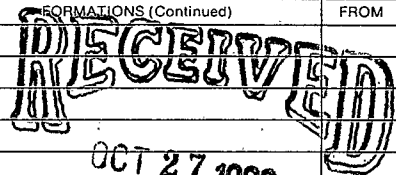FORMATIONS (Continued)	FROM	TO
 OCT 27 1998 Dept of Environmental Quality Office of Land and Water Resources		

IF MORE SPACE IS NEEDED, USE BACK

If well telescopes please sketch and show depths.

GROUND LEVEL

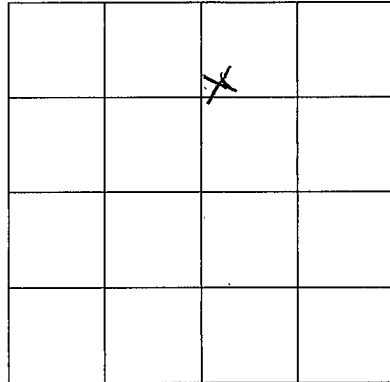

SECTION 10

Please indicate well location X.

ADDITIONAL INFORMATION

If more than one screen,
show location of each on sketch.