County: Lef lore Part 1 Permit 4: Gississippi Department of Environmental Quality Office of Land and Water Resources P.O. Box 10631 Aquifer: Jack drilling completed: 9-28-05 No. 10631 State Law requires that this report be prepared by the driller in detail and filed with the Department 30 days of completion of drilling of the well. Well Water Information Well Owner Name George Saunders Well Constitution Mailing Address: 7700 County Road 555 Method of Lat/Long (circle one): Conventional Surve USGS quad, Hand-hold GFS, Survey-grade GI Miles NE ½ NE ½ Sec 20 Twn 19N Rag Distance Direction Nearest Town Miles North of Lat Bena Well Owner Name 9-28-05 Date well drilling stated: 9-28-05 Well Data Well Data Nearest Town Purpose of Well (circle one) Home Industrial Public Supply Tringator Fish Culture Other: Static Water Level: 36 ' feet above on colored (circle one) land surface Date measured: 9-28-05 Static Water Level: 36 ' feet above on colored (circle one) land surface Date measured: 9-29-05 Static Water Level: 36 ' f	<u></u>
Permit #:	niy:
January 1 Jackson, MS 39289-0631 (601)961-5210 (601)354-6938 (fax) L S. Elevation:	
Date drilling completed: 9-28-05 Jackson, MS 39289-0631 (601)961-5210 (601)354-6938 (fax) L S. Elevation: State Law requires that this report be prepared by the driller in detail and filed with the Department' 30 days of completion of drilling of the well. Well Owner Information Well Owner Information Well Owner Information Well Location Date state Law requires that this report be prepared by the driller in detail and filed with the Department' 30 days of completion of drilling of the well. Well Content Well Owner Information Well Owner Information Well Location Date state 7700 County Road 555 Method of Lat/Long (circle one): Conventional Surve USGS quad, Hand-held GPS, Survey-grade GI Mailing Address: 7700 County Road 555 Method of Lat/Long (circle one): Conventional Surve USGS quad, Hand-held GPS, Survey-grade GI Telephone No. () Well Data Direction Nearest Town Miles North of Itta Bena Purpose of Well (circle one) Home Industrial Public Supply (Irrigation Fish Culture Other: State Well drilling statted: 9-28-05 Date well drilling completed: 9-28-05 Static Water Level: 36 ' feet above orbeitow (circle one) land surface Date measured: 9-29-05 Method of Measurement (circle one) stel tabe electric tape air line	22
Date drilling completed: 9-28-05 Image: Completion of completion com	
(601)354-6938 (fax) Edg #:	
State Law requires that this report be prepared by the driller in detail and filed with the Department 30 days of completion of drilling of the well. Well Owner Information Well Owner Information Well Owner Information Well Owner Information Well Cocation Well Cocation Well Cocation Mailing Address: 7700 County Road 555 Method of Lat/Long (circle one): Conventional Surve USGS quad, Hand-held GPS, Survey-grade GI Intta Bena, MS 38941 City State Zip Code Well Data Purpose of Well (circle one) Home Industrial Public Supply Irrigation Purpose of Well (circle one) Home Industrial Public Supply Irrigation Well Data Purpose of Well (circle one) Home Industrial Public Supply Irrigation Static Water Level: 9-28-05 Date well drilling started:	
Well Owner Information Well Location Downer Name George Saunders Intrace 33 °30 '.17N" Longitude: 90 °.18 Mailing Address: 7700 County Road 555 Method of Lat/Long (circle one): Conventional Survey Itta Bena, MS 38941 City State Zip Code Telephone No. (within
Dwner Name George Saunders Latitude: 33 •30 .17N+ Longitude: 90 •16 Mailing Address: 7700 County Road 555 Method of Lat/Long (circle one): Conventional Survey-grade Gircle one): Convention Conventor Survey-grade Gircle one): Convent Gi	
Itta Bena, MS 38941 City State Zip Code NE ¼ NE ¼ Sec_20 Twn 19N Rng Distance Direction Nearest Town Miles North of Itta Bena Well Data Well Data Purpose of Well (circle one) Home Industrial Public Supply Irrigation Date well drilling started: 9-28-05 Date well drilling completed: 9-28-05 If flowing, method of flow regulation: Valve Other (describe)	8. • 82¥
Itta Bena, MS 38941 City State Zip Code Telephone No. ()	. 9
Itta Bena, MS 38941 Zip City State Zip Code Telephone No. (2S
Itta Bena, MS 38941 City State Zip Code Distance Direction Nearest Town Miles North of Itta Bena Well Data Purpose of Well (circle one) Home Industrial Public Supply Circetion Nearest Town Mell Data Purpose of Well (circle one) Home Industrial Public Supply Circetion Nearest Town Mell Data Purpose of Well (circle one) Home Industrial Public Supply Circetion Other: 9-28-05 Date well drilling completed: 9-28-05 Static Water Level: 36' feet above or below (circle one) land surface Date measured: 9-29-05 Method of Measurement (circle one) static tape air line other: Top of grout (circle one): Cement Bentonite Mix <t< td=""><td>1 W</td></t<>	1 W
Telephone No. (
Telephone No. (
Well Data Purpose of Well (circle one) Home Industrial Public Supply Irrigation Fish Culture Other:	
Purpose of Well (circle one) Home Industrial Public Supply Initiation Fish Culture Other:	
Date well drilling started: 9-28-05 Date well drilling completed: 9-28-05 If flowing, method of flow regulation: Valve Other (describe) 9-29-05 Static Water Level: 36' feet above or below (circle one) land surface Date measured: 9-29-05 Method of Measurement (circle one) steel tarke electric tape air line other: 9-29-05 Hole depth: 125' Well depth: 125' Well grouted to a depth of 10_feet Type of grout (circle one): Cement Bentonite Mix Nix Casing length: 85_feet Casing diameter: 10_inches Type of screen: PVC Screen length: 40_feet Screen diameter: 10_inches Type of screen: PVC Screen slot size: .050_inches Setting depth: From 86_feet to 125_feet Type of completion (circle all applicable): Gravel packed Underreamed Telescoped Open hole Natural Develocitie):	
Date well drilling started: 9-28-05 Date well drilling completed: 9-28-05 If flowing, method of flow regulation: Valve Other (describe) 9-29-05 Static Water Level: 36' feet above or below (circle one) land surface Date measured: 9-29-05 Method of Measurement (circle one) steel tare electric tape air line other: 9-29-05 Method of Measurement (circle one) steel tare electric tape air line other: 9-29-05 Hole depth: 125' Well depth: 125' Well grouted to a depth of 10_feet Type of grout (circle one): Cement Bentonite Mix Screen length: 40_feet Screen diameter: 10_inches Type of screen: PVC Screen slot size: .050_inches Setting depth: From 86_feet to 125_feet Type of completion (circle all applicable): Gravel packed Underreamed Telescoped Open hole Natural Develocitie):	
If flowing, method of flow regulation: Valve Other (describe) Other (describe) Static Water Level:36 ' feet above or below (circle one) land surface Date measured:9-29-05 9-29-05 Method of Measurement (circle one) steel take electric take air line other: Hole depth:125 ' Well depth:125 ' Well grouted to a depth of10feet 10feet feet Type of grout (circle one): Cement Bentonite Mix Mix Casing length:85feet Casing diameter:10inches Type of casing:	
Static Water Level: 36' feet above or below (circle one) land surface Date measured: 9-29-05 Method of Measurement (circle one) steel taple electric tape air line other:	
Static Water Level: 36' feet above or below (circle one) land surface Date measured: 9-29-05 Method of Measurement (circle one) steel tape electric tape air line other:	
Method of Measurement (circle one) steel tape electric tape air line other:	
Type of grout (circle one): Cement Bentonite Mix Casing length: 85 feet Casing diameter: 10 inches Type of casing: PVC Screen length: 40 feet Screen diameter: 10 inches Type of screen: PVC Screen slot size: .050 inches Setting depth: From 86 feet to 125 feet Type of completion (circle all applicable): Gravel packet Underreamed Telescoped Open hole Natural Devel Other (describe):	<u> </u>
Casing length: 85 feet Casing diameter: 10 inches Type of casing: PVC Screen length: 40 feet Screen diameter: 10 inches Type of screen: PVC Screen slot size: .050 inches Setting depth: From 86 feet to 125 feet Type of completion (circle all applicable): Gravel packed Underreamed Telescoped Open hole Natural Devel Other (describe):	
Screen length: 40 feet Screen diameter: 10 inches Type of screen: PVC Screen slot size: .050 inches Setting depth: From 86 feet to 125 feet Type of completion (circle all applicable): Gravel packed Underreamed Telescoped Open hole Natural Devel Other (describe):	
Screen slot size: <u>.050</u> inches Setting depth: From <u>86</u> feet to <u>125</u> feet Type of completion (circle all applicable): Gravel packed Underreamed Telescoped Open hole Natural Devel Other (describe):	
Type of completion (circle all applicable): Gravel packed Underreamed Telescoped Open hole Natural Devel Other (describe):	
Other (describe):	κ.
• • • •	lopment
Top of lap pipe or reduction in casing: feet If telesconed or more than one screen, describe on back	
TOD OF IAD PHOLOF IN CAMINE.	of page
Logs run (circle all applicable): No log run Electric Gamma Ray Density Sonic Neutron Other:	
Name of organization running log(s): I certify that the well was drilled, constructed, and completed in accordance with all applicable requirements of the	
Department of Environmental Quality and/or the Mississippi Department of Health regulations and state Jaws.	
Irrigation Equipment Inc.	
Patrick M. Chism 0695	
Print Name of Water Well Contractor and License No.	

RECEIV!


If well telescopes please sketch below and show depths.

Ground Level

Description of Formations Encountered	From	To
Clay	0	21
Fine sand	22	45
Fine Sand/gravel	46	52
Med. Sand/gravel Fine Sand/gravel Med. Sand/gravel	53	74
Fine Sand/gravel	/5	81
Med. Sand/gravel	82	125
		┣──┨
	_	┣┫
		<u> </u>
	·	
	_	
	_	┼──┤

k-``

If more than one screen, show location of each on sketch

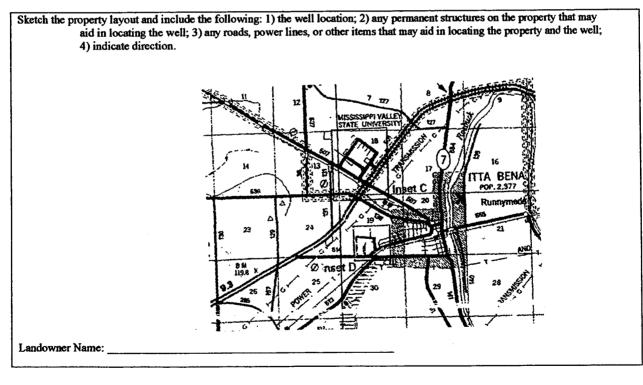

Signature of Water Well Contractor

• • •				
	STATE WI	ELL REPORT		
County: Leflore Permit #: <u>Current 10355</u> Irrigation Equipment Driller: <u>9-29-05</u>	Part 2 Pump Installer's Completion Report Mississippi Department of Environmental Quality		For Office Use Only: Aquifer: Well #: <u>K- 122</u> Elevation:	
This report should be prepared by the installation of pump.	1e pump installer in deta	il and filed with the Departm	ent within 30 days of the	
Well Owner Informat	tion	We	Il Location	
Owner Name: George Saunde	rs	Latitude:Longitude:		
Mailing Address: 7700 Count		Method of Lat/Long (circle or		
		USGS quad. Han	d-held GPS, Survey-grade GPS	
Itta Bena, City State	MS 38941 Zip Code			
			Nearest Town	
Telephone No. ()		<u> </u>	of Itta Bena	
Pum p Type Circle one		Power Type Circle one		
Air Lift Jet	Submersible	Diesel Engine Gasoli	ne Engine Natural Gas	
Bucket Piston	Turbine	Electric Motor Hand	Tractor PTO	
Centrifugal Rotary	Flowing Well	Windmill Other	(specify):	
Other (specify):		Horse Power Rating of Motor: 20		
Date Pump Installed: 9-29-05		Setting Depth:	70 feet	
900-1000 Rated Pump Capacity:	Gallons Per Minute	Number of Stages:	1	
Pump Test Data		Method of Measuring Water Level		
Date Well Tested:		C	Circle one	
Static Water Level (A): Feet		Air Line Electric Mea	asuring Line Steel Tape	
Pumping Water Level (B):Feet		Other (specify):		
·				
Drawdown [(B) – (A)]:Feet	Below Land Surface	For flowing well, measured si	hut in head:feet	
			hut in head:feet GPM with a drawdown of	

ŧ

.

	I HEREBY CERTIFY that the above statements are true to the bes	st of my my wjedge.		
	Patrick M. Chism 0695	Patrice M Chu		
-	Print Name of Pump Installer and License No. (if applicable)	Signature of Pump Installer		
			RECEIV	ED

0CT 1 1 2005 BY: OLWR