

County: Leflore
 Permit #: GW42308
 Irrigation Equipment
 Driller: _____
 Date drilling completed: 12-8-07

**State Well Report
 Part I**

Mississippi Department of Environmental Quality
 Office of Land and Water Resources
 P.O. Box 10631
 Jackson, MS 39289-0631
 (601)961-5210
 (601)354-6938 (fax)

For Office Use Only:
 Aquifer: _____
 Well #: K-131
 L.S. Elevation: _____
 E-log #: _____

State Law requires that this report be prepared by the driller in detail and filed with the Department within 30 days of completion of drilling of the well.

Well Owner Information	Well Location
Owner Name: <u>George Saunders</u>	Latitude: <u>33.30.14.7</u> Longitude: <u>90.18.29.3</u>
Mailing Address: <u>7700 County Rd. 555</u>	Method of Lat/Long (circle one): <u>15</u> Conventional Survey, <u>29</u>
<u>Itta Bena Ms. 38941</u>	USGS quad, Hand-held GPS, Survey-grade GPS
City State Zip Code	<u>SE 1/4 NW 1/4 Sec 21 Twn 19N Rng 1W</u>
Telephone No. <u>(662) 254-9182</u>	Distance Direction Nearest Town <u>1</u> Miles <u>East</u> of <u>Itta Bena</u>

Well Data

Purpose of Well (circle one) Home Industrial Public Supply Pivot Irrigation Fish Culture Other

Date well drilling started: 12-8-07 Date well drilling completed: 12-8-07

If flowing, method of flow regulation: Valve _____ Other (describe) _____

Static Water Level: 37 feet above or below (circle one) land surface Date measured: 12-12-07

Method of Measurement (circle one) steel tape electric tape air line other _____

Hole depth: 118 Well depth: 118 Well grouted to a depth of 10 feet

Type of grout (circle one): Cement Bentonite Mix

Casing length: 78 feet Casing diameter: 16 inches Type of casing: PVC

Screen length: 40 feet Screen diameter: 16 inches Type of screen: PVC

Screen slot size: .032/.050 inches Setting depth: From 7.5 feet to 115 feet

Type of completion (circle all applicable): Gravel packed Underreamed Telescoped Open hole Natural Development
 Other (describe): _____

Top of lap pipe or reduction in casing: _____ feet. If telescoped or more than one screen, describe on back of page

Logs run (circle all applicable): No log run Electric Gamma Ray Density Sonic Neutron Other _____

Name of organization running log(s): _____

I certify that the well was drilled, constructed, and completed in accordance with all applicable requirements of the Mississippi Department of Environmental Quality and/or the Mississippi Department of Health regulations and state laws.

Irrigation Equipment Inc.
 Patrick M. Chism 0695

Print Name of Water Well Contractor and License No. _____ Signature of Water Well Contractor Patrick M. Chism

STATE WELL REPORT

Part 2

Pump Installer's Completion Report
Mississippi Department of Environmental Quality
Office of Land and Water Resources
P.O. Box 10631
Jackson, MS 39289-0631
(601)961-5210
(601)354-6938 (fax)

County: Leflore
Permit #: _____
Irrigation Equipment
Boiler: _____
Date completed: 12-8-07

For Office Use Only:
Aquifer: _____
Well #: K-131
Elevation: _____

This report should be prepared by the pump installer in detail and filed with the Department within 30 days of the installation of pump.

Well Owner Information	Well Location
Owner Name: <u>George Saunders</u>	Latitude: _____ Longitude: _____
Mailing Address: <u>7700 County Rd 555</u>	Method of Lat/Long (circle one): <input type="radio"/> Conventional Survey, <input type="radio"/> USGS quad, <input type="radio"/> Hand-held GPS, <input type="radio"/> Survey-grade GPS
<u>Itta Bena Ms. 38941</u> City State Zip Code	<u>SE 1/4 NW 1/4 Sec 21 Twp 19N Rng 1W</u>
Telephone No. <u>(662) 254-9182</u>	Distance Direction Nearest Town <u>1 Miles East of Itta Bena</u>

Pump Type Circle one	Power Type Circle one
Air Lift <input type="checkbox"/> Jet <input type="checkbox"/> Submersible <input type="checkbox"/>	<input checked="" type="checkbox"/> Diesel Engine <input type="checkbox"/> Gasoline Engine <input type="checkbox"/> Natural Gas
Bucket <input type="checkbox"/> Piston <input type="checkbox"/> <input checked="" type="checkbox"/> Turbine <input type="checkbox"/>	Electric Motor <input type="checkbox"/> Hand <input type="checkbox"/> Tractor PTO
Centrifugal <input type="checkbox"/> Rotary <input type="checkbox"/> Flowing Well <input type="checkbox"/>	Windmill <input type="checkbox"/> Other (specify): _____
Other (specify): _____	Horse Power Rating of Motor: <u>40</u>
Date Pump Installed: <u>12-12-07</u>	Setting Depth: <u>60</u> feet
Rated Pump Capacity: _____ Gallons Per Minute	Number of Stages: <u>2</u>

Pump Test Data	Method of Measuring Water Level Circle one
Date Well Tested: _____	<input type="checkbox"/> Air Line <input type="checkbox"/> Electric Measuring Line <input type="checkbox"/> Steel Tape
Static Water Level (A): _____ Feet Below Land Surface	Other (specify): _____
Pumping Water Level (B): _____ Feet Below Land Surface	For flowing well, measured shut in head: _____ feet
Drawdown [(B)-(A)]: _____ Feet Below Land Surface	Well yielded _____ GPM with a drawdown of _____ feet after _____ hours of pumping
Test Pumping Rate: _____ Gallons Per Minute	
Duration of Pump Test (minimum 4 hours): _____ hours	

I HEREBY CERTIFY that the above statements are true to the best of my knowledge.


Patrick M. Chism 0695
Print Name of Pump Installer and License No. (if applicable)

Patro
Signature of Pump Installer

REC'D W-1
DEC 21 2007
BY: OLWR

George Saunders Map
6W42308

248 F3
249 E2, F2
250 E2
251 E3
252 E3
253 B4, C3
254 D2, E2
255 E2
256 E2
257 B4, F1
258 B4, F1
259 D4, E4, G1
260 F1
261 F1
282 D1, E1, E2
283 E1
284 F1
285 F1
300 C3
301 D1
302 D1
303 D1
304 D2
305 D2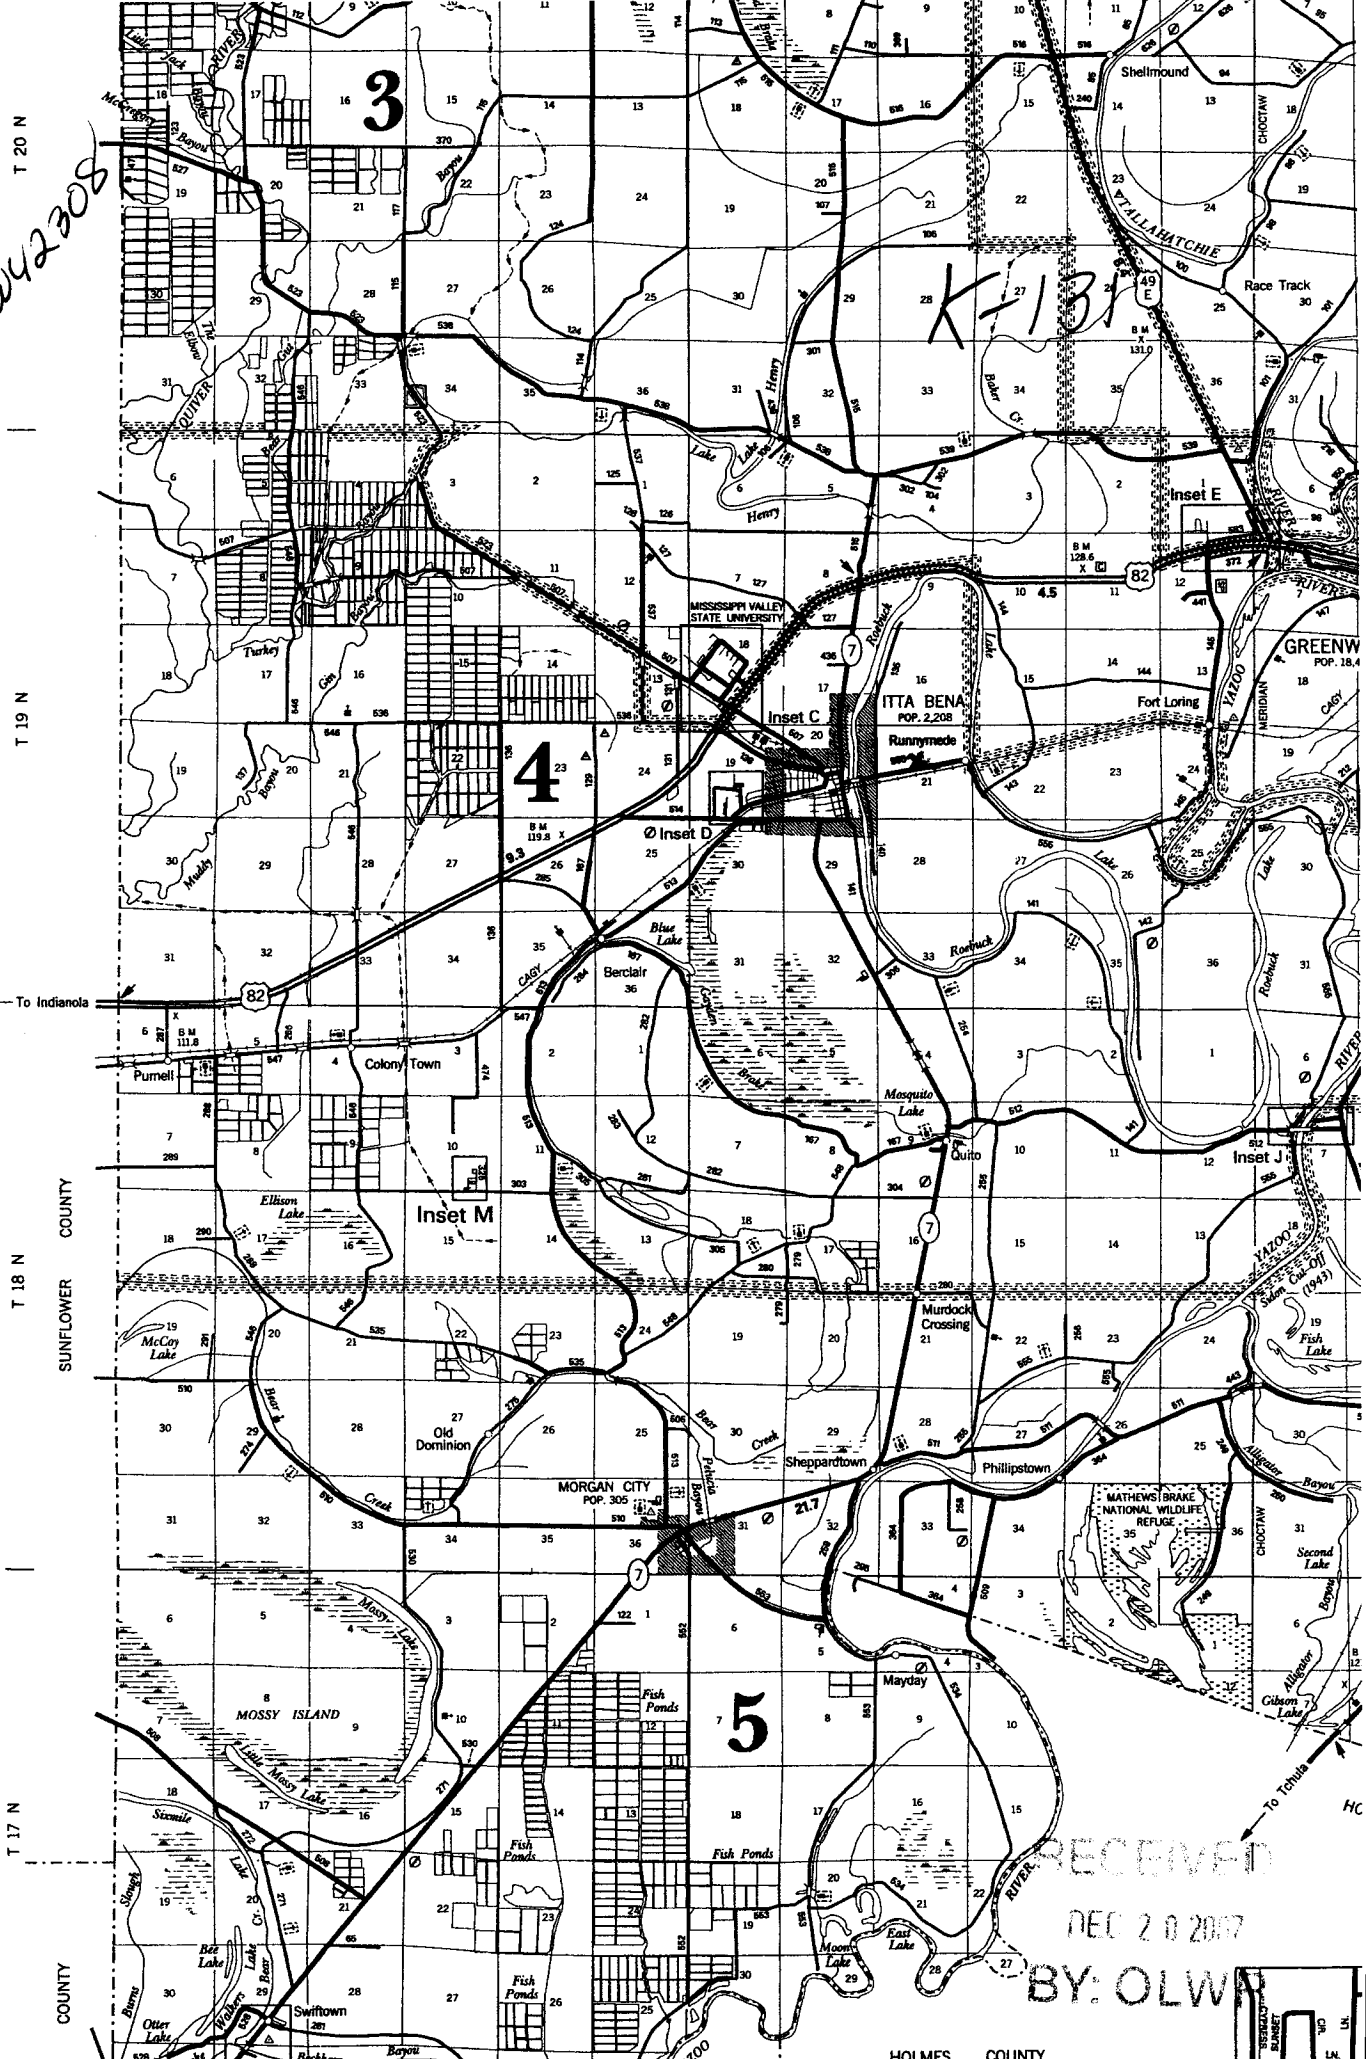
RECEIVED
DEC 20 2007
BY: OLWD