

**BEFLORE**  
**R 2000**  
**9-1-76**

MISSISSIPPI  
 BOARD OF WATER COMMISSIONERS  
 416 North State Street  
 15J Jackson, Mississippi 39201

**WATER WELL DRILLERS LOG**

9-1-76  
 date well completed

19 **FUJIANE GAS CO. OF GREENWOOD** *Lefflore*  
 firm name county well located

LANDOWNER: **JOHN STANFORD**  
*M<sup>c</sup>Intyre Estate*  
*Ftta Bena*  
 (mailing address)

WELL LOCATION:  
 sec. **34** T. **19** (N) R. **1** (E)  
**2** miles **SE** of *Ftta Bena*  
 (distance) (direction) (nearest town)

description of formations encountered	from	to
Clay	0	10
SAND	10	30
SAND + PAW GRAVEL	30	68
GRAVEL	68	163
Clay	163	213
SAND	213	230
SAND + SLTILE	230	310
SAND	310	355
SHALE	355	390
SAND	390	460
SANDY SHALE	460	503
SHALE + ROCK	503	705
SHALE	705	783
SAND + SHALE	783	803
GREEN SAND	803	825
SHALE	825	863
SHALE ROCK	863	925
FINE SAND	925	1035
GUMMY SHALE	1035	1225
		None

WELL PURPOSE: *Home*  
 (home, irrigation, municipal, industrial)

WELL COMPLETION DATA:

(1) diameter (inches) **4 1/2**

(2) total depth (feet) **1008** *well*

(3) static water level (feet) **5** *below* above top of ground.

(4) casing *Steel* **988** *CL*  
 (material) (depth)  
**4 1/2** if telescope see back.  
 (size)

(5) screen **20** **988**  
 (length) (depth to top)  
**2"** *Stainless*  
 (size) (material)

(6) pump **2** **30**  
 (HP) (yield gpm)  
**FLC**  
 (type power)

(7) electric log **yes**  
 (yes or no)  
**MGS**  
 (organization running log)

(8) how well bottom plugged  
*Lead Plug*

**RECEIVED**  
 SEP - 7 1976

DRILLERS REMARKS:

MISS. BD. OF WATER COMMISSIONERS


If well telescopes please sketch and show depths.

GROUND LEVEL

105' - 4" CASING →

883' - 2" CASING →

20' - 2" SCREEN →

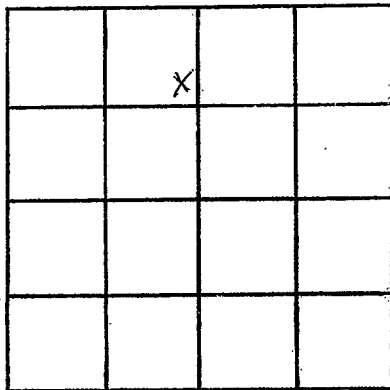

SECTION 34

Please indicate well location X.

ADDITIONAL INFORMATION

If more than one screen, show locations of each on sketch.