

Leflore

R<sup>O</sup> 2002

3/22/77

MISSISSIPPI  
 BOARD OF WATER COMMISSIONERS  
 416 North State Street  
 Jackson, Mississippi 39201

15H

WATER WELL DRILLERS LOG

3/22/77

BUTANE GAS CO. OF GREENWOOD

Leflore

date well completed

firm name

county well located

LANDOWNER:

Runnymede Plantation

ITTA BENA

(mailing address)

description of formations encountered

from

to

Clay

0

18

SAND

18

60

SAND + GRAVEL

60

94

WELL LOCATION:

sec. 21 T. 19 N. R. 1 E  
 S W  
 miles 1 E of ITTA BENA  
 (distance) (direction) (nearest town)

WELL PURPOSE:

(home, irrigation, municipal, industrial) AG

WELL COMPLETION DATA:

- (1) diameter (inches) 4
- (2) total depth (feet) 94
- (3) static water level (feet) 18 below above top of ground.
- (4) casing PVC 94 cu (material) (depth)  
4 if telescope see back. (size)
- (5) screen 20 74 (length) (depth to top)  
4 (size) PVC (material)
- (6) pump 3/4 20 (HP) (yield gpm)  
Elec. (type power)
- (7) electric log no (yes or no)

(organization running log)

(8) how well bottom plugged Back Press Jte JAWP

DRILLERS REMARKS:


RECEIVED

MAR 25 1977

MISS. BD. OF WATER COMMISSIONERS

If well telescopes please sketch and show depths.

GROUND LEVEL

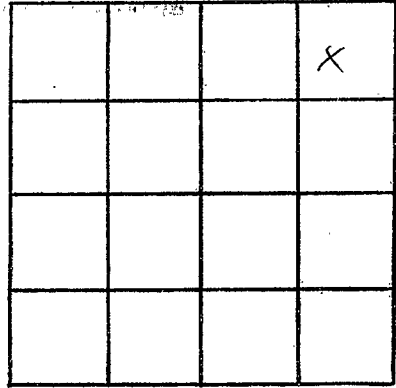

SECTION 21

Please indicate well location X.

ADDITIONAL INFORMATION

If more than one screen, show locations of each on sketch.