

Leflore
K 9053
May 6, 1977

MISSISSIPPI
BOARD OF WATER COMMISSIONERS
416 North State Street
15J Jackson, Mississippi 39201

WATER WELL DRILLERS LOG


May 6 19 77 Bruce Berryman - LEFLORE
date well completed firm name county well located
 Greenwood, Miss.

LANDOWNER:	Dr. Robert Gordon	description of formations encountered	from	to
506 11th,		Clay	0	20
Greenwood, Miss. 38930		Sand	20	60
(mailing address)		Gravel & Sand	60	120
		Clay	120	160
WELL LOCATION:		Sandy Clay	160	180
sec. 13 T 19 ^N R 1 ^E		Sand	180	220
4 miles ^S W of ^W GREENWOOD		Clay & Str. sand	220	260
(distance) (direction) (nearest town)		Shale	260	300
WELL PURPOSE: Home		Clay	300	380
(home, irrigation, municipal, industrial)		Green sand	380	440
		Sandy shale	440	520
WELL COMPLETION DATA:		Sand	520	540
(1) diameter (inches) 4" x 2"		Shale	540	550
(2) total depth (feet) 751'		Fine brown sand	550	580
(3) static water level (feet) 3' below abstract top of ground		Shale	580	640
(4) casing 2" blk. galv. = 105' (material) 625' (depth)		Sand	640	670
		Shale	670	730
		Sand	730	755
		Shale	755	770
If telescope see back.				
(5) screen 20 731' (length) (depth to top)				
.010 Stainless steel (size) (material)				
(6) pump 1 h.p. 30 (HP) (yield gpm)				
electric (type power)				
(7) electric log No (yes or no)				
(organization running log)				
(8) how well bottom plugged B.P.V.				
DRILLERS REMARKS:				

RECEIVED
SEP 16 1977

If well telescopes please sketch and show depths.

GROUND LEVEL

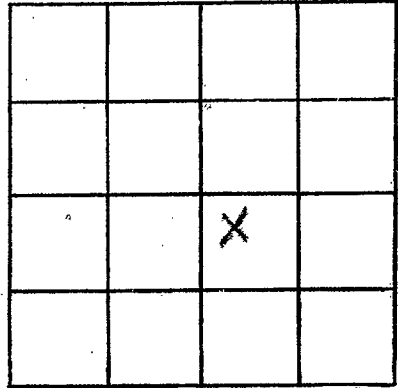

SECTION 13

Please indicate well location X.

ADDITIONAL INFORMATION

If more than one screen,
show locations of each on sketch.