

LeFlore  
K 7006  
3/3/78

MISSISSIPPI  
BOARD OF WATER COMMISSIONERS  
416 North State Street  
Jackson, Mississippi 39201

WATER WELL DRILLERS LOG  
BUTANE GAS COMPANY

3/3/78  
date well completed 19

OF GREENWOOD

LeFlore  
county well located

LANDOWNER:  
Jimmie Green  
Itha Bena  
(mailing address)

WELL LOCATION:  
sec. 5 T. 19 N R. 2 E  
4 miles N of Itha Bena  
(distance) (direction) (nearest town)

description of formations encountered	from	to
Clay	0	75
Sand	15	50
Sand & Gravel	50	103

WELL PURPOSE: Home  
(home, irrigation, municipal, industrial)

WELL COMPLETION DATA:

(1) diameter (inches) 4"

(2) total depth (feet) 100

(3) static water level (feet) 18 <sup>below</sup> top of ground

(4) casing PVC, 80 (depth)  
4" (size) if telescope see back.

(5) screen 20' (length), 80 (depth to top)  
4" (size), PVC (material)

(6) pump (HP) (yield gpm)  
(type power)

(7) electric log (yes or no)  
(organization running log)

(8) how well bottom plugged


DRILLERS REMARKS:

RECEIVED  
MAR 21 1978

MISS. BD. OF WATER COMMISSIONERS

If well telescopes please sketch and show depths.

GROUND LEVEL

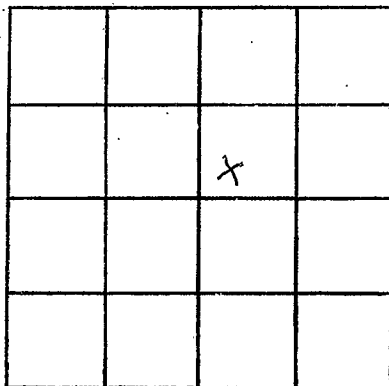

SECTION 5

Please indicate well location X.

ADDITIONAL INFORMATION

Lined area for additional information.

If more than one screen, show locations of each on sketch.