

LEFLORE
K 2007
02-15-79

**MISSISSIPPI
BOARD OF WATER COMMISSIONERS**
416 North State Street
Jackson, Mississippi 39201
WATER WELL DRILLERS LOG


Feb. 15 1979 Bruce Berryman Leflore
 date well completed firm name county well located
 Greenwood.

LANDOWNER: Florewood Living Plantation Greenwood. MS. 38930 (mailing address)	description of formations encountered	from	to
WELL LOCATION: sec. 12 T 19 N R 1 W 4 miles W of Greenwood (distance) (direction) (nearest town)			
WELL PURPOSE: Duck pond (home, irrigation, municipal, industrial)	Clay	0	20
WELL COMPLETION DATA:	Sand	20	60
(1) diameter (inches) 4" x 2"	Sand & gravel	60	140
(2) total depth (feet) 943'	Clay	140	160
(3) static water level (feet) 3' below top of 4" blk. - 126'	Sand	160	280
(4) casing 2" galv. - 787' (material) (depth)	Shale	280	360
if telescope see back.	Green sand and rock	360	380
(5) screen 30' 913' (length) (depth to top)	Green sand	380	440
2" .010 Stainless steel (size) (material)	Shale	440	460
(6) pump 1 1/2 h.p. 35 (HP) (yield gpm)	Green sand	460	480
Electric (type power)	Shale	480	500
(7) electric log NO (yes or no)	Green sand	500	560
(organization running log)	Hard rock	520	
(8) how well bottom plugged B.P.V.	Brown sand	560	600
	Shale & str. sand	600	670
	Sand	670	690
	Shale	690	730
	Sand	730	750
	Shale	750	800
	Shale & str. sand	800	840
	Fine sand	840	880
	Sand	880	950

DRILLERS REMARKS: Miss. Board of Water Comm.
 MAY - 8 1979
RECEIVED

If well telescopes please sketch and show depths.

GROUND LEVEL

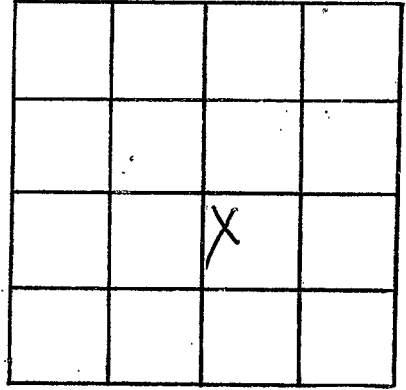

SECTION 12

Please indicate well location X.

ADDITIONAL INFORMATION

If more than one screen,
show locations of each on sketch.