

LEFLORE

K 2008

1-22-79

MISSISSIPPI BOARD OF WATER COMMISSIONERS 416 North State Street Jackson, Mississippi 39201

WATER WELL DRILLERS LOG

BUTANE GAS COMPANY OF GREENWOOD

K Leflore county well located

1-22-79 19 date well completed


LANDOWNER: Tootie Melcalfe IFA BENT (mailing address)

Table with 4 columns: description of formations encountered, from, to. Rows include Clay, Sand, Gravel, Sandy Shale, Sand + Shale streaks, Hard Shale, Shale + Rock, Sand, Sandy Shale, Fine Sand + Shale, Gummy shale, Sandy Shale, Fine Sand, Coarse Sand.

WELL LOCATION: sec. 15 T. 19 N. R. 1 E. 1/2 miles NE of IFA BENT (distance) (direction) (nearest town)

WELL PURPOSE: Home (home, irrigation, municipal, industrial)

- WELL COMPLETION DATA: (1) diameter (inches) 4 1/2 (2) total depth (feet) 1018 (3) static water level (feet) 20 below top of ground. (4) casing Steel 988 (material) (depth) 4 1/2 (size) if telescope see back. (5) screen 30 988 (length) (depth to top) 2" stainless (size) (material) (6) pump 1 1/2 30 (HP) (yield gpm). Elec. (type power) (7) electric log NO (yes or no) (organization running log)

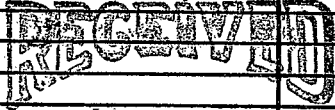

JAN 25 1978

MISS. BD. OF WATER COMM

(8) how well bottom plugged Back Pressure Valve

DRILLERS REMARKS:

If well telescopes please sketch and show depths.

GROUND LEVEL

170' - 4" CASING →

862' - 2" CASING →

30' - 2" SCREEN →

X			

SECTION N

Please indicate well location X.

ADDITIONAL INFORMATION

If more than one screen, show locations of each on sketch.