

MISSISSIPPI DEPARTMENT OF NATURAL RESOURCES

Bureau of Land and Water Resources

Southport Mall

P.O. Box 10631

Jackson, Mississippi 39209

WATER WELL DRILLERS LOG

Leflore  
K. 2009  
4/21/83

April 21 19 83 Bruce Berryman Leflore.  
date well completed firm name county well located  
Greenwood.

LANDOWNER: G & H Brokerage Inc., 1211 HWY82 By-Pass Greenwood. MS 38930 (mailing address)	description of formations encountered	from	to
WELL LOCATION: sec. 12 T 19 N R 1 W 2 miles West of Greenwood (distance) (direction) (nearest town)	Clay	0	40
	Sand	40	80
	Sand & Gravel	80	140
	Sand	140	270
	Clay	270	300
	Shale	300	320
	Shale & rock	320	380
	Green sand	380	430
	Shale	430	440
	Sands	440	460
Shale	460	470	
WELL PURPOSE: Industrial (home, irrigation, municipal, industrial)			

WELL COMPLETION DATA:

(1) diameter (inches) 2" x 4"

(2) total depth (feet) 451'

(3) static water level (feet) 10' below top of ground.

(4) casing 4" blk. - 126'  
2" galv. - 305'  
(material) (depth)

         if telescope see back.  
(size)

(5) screen 20' 431'  
(length) (depth to top)

2" .010 gauge Stainless  
(size) (material) Steel

(6) pump 1 h.p. 20  
(HP) (yield gpm)

Electric  
(type power)

(7) electric log NO  
(yes or no)

          
(organization running log)

(8) how well bottom plugged B.P.V.

DEPT. OF NATURAL RESOURCES  
BUREAU OF LAND & WATER RESOURCES


MAY 12 1983

RECEIVED

DRILLERS REMARKS:

If well telescopes please  
sketch and show depths.

GROUND LEVEL

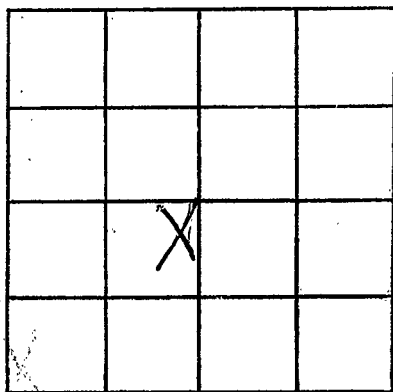

SECTION 12

Please indicate well location X.

ADDITIONAL INFORMATION

If more than one screen,  
show locations of each on sketch.