

MISSISSIPPI DEPARTMENT OF NATURAL RESOURCES

Bureau of Land and Water Resources

Southport Mall

P.O. Box 10631

Jackson, Mississippi 39209

WATER WELL DRILLERS LOG

LEFLORE  
K2011

6-18  
date well completed

BUTANE GAS CO. OF GREENWOOD

firm name

Lefflore  
county well located

LANDOWNER:  
Bill Pillow  
  
(mailing address)

description of formations encountered	from	to
CLAY	0	65
fine sand	65	85
gravel	85	110
Rock	110	112
Sand & gravel	112	130
sand clay	130	190
sand	190	285
sandy shale	185	370
shale & rock	370	370
fine shale sand	370	470
sand	470	470
sand shale	470	480

WELL LOCATION:  
sec. 13 T 19 N R. 1 E  
S W  
1/2 miles NE of Fort Loring  
(distance) (direction) (nearest town)

WELL PURPOSE: Home  
(home, irrigation, municipal, industrial)

- WELL COMPLETION DATA:
- (1) diameter (inches) 4" x 2"
  - (2) total depth (feet) 461
  - (3) static water level (feet) 11 <sup>below</sup>/<sub>above</sub> top of ground.
  - (4) casing Steel, 4" 105'  
(material) (depth), 2" 336'  
4" x 2"  
(size) if telescope see back.
  - (5) screen 20', 241'  
(length) (depth to top)  
2", Stamper steel  
(size) (material)
  - (6) pump 1, 20  
(HP) (yield gpm)  
Electric  
(type power)
  - (7) electric log No  
(yes or no)  
No  
(organization running log)
  - (8) how well bottom plugged 100  
Back wash Valve


RECEIVED  
AUG 12 1996

Department of Natural Resources  
Bureau of Land & Water Resources

DRILLERS REMARKS:  
Richard West

If well telescopes please sketch and show depths.

GROUND LEVEL

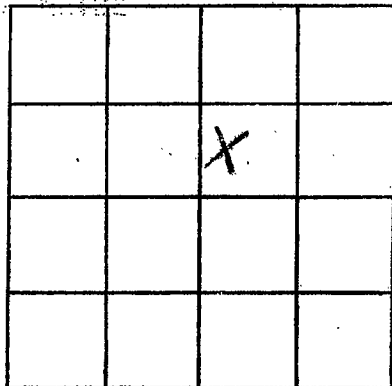

SECTION 13

Please indicate well location X.

ADDITIONAL INFORMATION

If more than one screen, show locations of each on sketch.