

MISSISSIPPI DEPARTMENT OF ENVIRONMENTAL QUALITY
Bureau of Land and Water Resources

P. O. Box 10631
Jackson, MS 39289-0631
WATER WELL DRILLERS LOG

COUNTY WELL LOCATED <i>Leflore</i>	
WELL NUMBER <i>K2014</i>	CODED
DATE WELL COMPLETED <i>2-12-91</i>	

PERMIT NUMBER
NAME OF DRILLING FIRM IRRIGATION EQUIPMENT
601/887-2555

NAME & MAILING ADDRESS OF LANDOWNER <i>INDIANOLA, MS</i> MAKAMSON FARMS <i>Rt. 3, Box 13</i> <i>ITTA BENA, MS</i>		
WELL LOCATION: SEC	TOWNSHIP	RANGE
<i>15</i>	<i>19</i> ^N	<i>1</i> ^E
DISTANCE	DIRECTION	NEAREST TOWN
<i>2</i> Miles	<i>NE</i>	of <i>ITTA BENA</i>
OTHER LANDMARK		
WELL PURPOSE: Home, Irrigation, Municipal, Industrial, Fish Pond, etc. <i>IRRIGATION-PIVOT</i>		

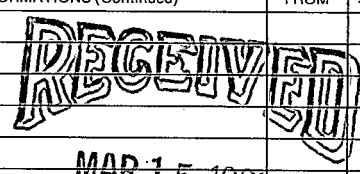
PUMP DATA		
PUMP TYPE (Circle One): Submersible, <u>Turbine</u> , Jet, Flowing Well, Other (Describe) _____		
POWER TYPE (Circle One): Electric, Tractor, <u>Diesel</u> , Gasoline, Butane, Other (Describe) _____ H/P <u>60</u>		
Pump Capacity (GPM)	No. of Stages	Setting Depth
<i>1200</i>	<i>3</i>	<i>50</i> FT.
PUMP TEST		
Well yielded _____ GPM with a drawdown of _____ ft. after _____ hours of pumping		

WELL DATA		
Well Depth	Casing Diameter (In.)	Casing Length (Ft.)
<i>95'</i>	<i>12</i>	<i>55</i>
Type of Casing	Hole Depth	Depth to Static Water Level
<i>steel</i>	<i>95'</i>	<i>22'</i>
TYPE OF COMPLETION: (Circle One or More): <u>Gravel Packed</u> , Underreamed, Telescoped, Natural Development, Open Hole, Other (Describe) _____		
Top of Lap Pipe or Reduction in Casing		
FEET		
IF TELESCOPED OR MORE THAN ONE SCREEN: USE BACK PAGE		

LOG DATA	
TYPE OF LOG RUN (Circle One): Electric, Gamma Ray, Density, Sonic, Neutron, Other (Describe) _____ No Log Run	
Name of Organization Running Log	

SCREEN DATA		
Diameter - Inches	Length - Feet	Slot Size - Inches
<i>12</i>	<i>40</i>	<i>0060</i>
Screen Type	Depth to Bottom - Feet	
<i>steel</i>	<i>95'</i>	

GEOLOGIC DATA (Office Use Only)			
Surface Elev.	Geologic Unit	Unit Thickness	Depth to Top
Subs. SWL	Date	Analysis	Aquifer Test
Driller's Remarks <i>Drilled for Big-D</i>			

DESCRIPTION OF FORMATIONS ENCOUNTERED	FROM	TO	FORMATIONS (Continued)	FROM	TO
<i>Clay</i>	<i>0</i>	<i>15</i>	 MAR 15 1991 Dept. of Environmental Quality Bureau of Land & Water Resources		
<i>Clay + Fine sand</i>	<i>15</i>	<i>25</i>			
<i>Fine sand</i>	<i>25</i>	<i>35</i>			
<i>medium sand</i>	<i>35</i>	<i>55</i>			
<i>Coarse sand</i>	<i>55</i>	<i>95</i>			

IF MORE SPACE IS NEEDED, USE BACK

If well telescopes please
sketch and show depths.

GROUND LEVEL

+			

SECTION 15

Please indicate well location X.

ADDITIONAL INFORMATION

If more than one screen,
show location of each on sketch.