

WATER WELL DRILLERS LOG

?

Before info to locate
 Date JUNE 10, 1961, Driller DELTA DRILLING Co. County LEFLORE

(Name)

6-10-61

(1) Owner of Land: P.L. GRIMMETT

(Name)

GREENWOOD, MISS.

(Address)

(2) Location: 1/4, 1/4, Sec. T. R.

 miles of
 (distance) (direction) (Nearest Town)

(3) Topography: (Hilly) (Flat) (Level)

(4) Purpose of Well: DOMESTIC
 (Domestic Irrigation, Municipal, Industrial, Other)

Description & Color of Materials Sand, Clay, Red Clay, Shell, etc.	Thick- ness Feet	Depth Feet
GUMBO	22	22
SAND	42	64
GRAVEL	64	128
SAND	47	175
GUMBO	17	192
SHALE w/2" ROCK	42	234
SAND w/5" ROCK	65	299
GREEN SAND -	64	365
SHALE	17	382

Information upon completion of well:


- (1) Diameter 2 inches.
- (2) Total Depth 382 feet.
- (3) Water Level feet below top of ground.
- (4) Cased to 382, Size 2"
- (5) Screen: Size 2", Length 63' - 2"
PERFORATED PIPE
- (6) Were any formations sealed against pollution?
 yes, no.

If YES depth of formation

Why

Drillers Remarks: 1/2 H.P. SHALLOW WELL

JET PUMP SET IN WELL

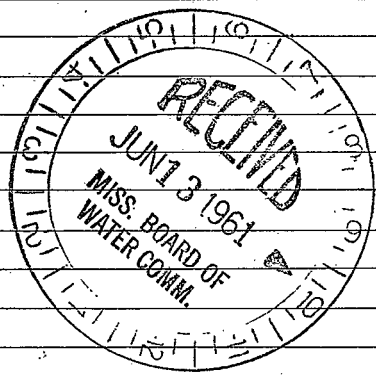

(Use Back Side)

Well No.

