

L

7-3-63

WATER WELL DRILLERS LOG

Date: July 3, 1963, Driller: DELTA DRILLING Co. County LEFLORE

8489

(Name)

(1) Owner of Land: P. L. MCGINNIS
 (Name)
GREENWOOD, MISS. *Pointester add.*
 (Address)

(2) Location: 1/4, 1/4, Sec. T R ,
 miles of ,
 (distance) (direction) (Nearest Town)

(3) Topography:
 (Hilly) (Flat) (Level)

(4) Purpose of Well: DOMESTIC
 (Domestic Irrigation, Municipal, Industrial, Other)

Description & Color of Materials Sand, Clay, Red Clay, Shell, etc.	Thick- ness Feet	Depth Feet
SAND	65	65
GRAVEL	61	126
SAND	30	156
GUMBO	96	252
SHALE	22	274
SAND	42	316
SHALE	64	380
GUMBO w/ROCKS-	62	442
SHALE	20	462
GUMBO	83	545
SHALE	18	563
SAND	20	583
SHALE	30	613
GUMBO	19	632
SAND	70	702

Information upon completion of well:

(1) Diameter 4 inches.

(2) Total Depth 702 feet.

(3) Water Level WELL FLOWS feet below top of ground.

(4) Cased to 682, Size 4" - 422' / 2" - 292'


(5) Screen: Size 2, Length 20.

(6) Were any formations sealed against pollution?
 yes, no.

If YES depth of formation

Why

Drillers Remarks: 12' LAP OF 2" IN 4" PIPE-

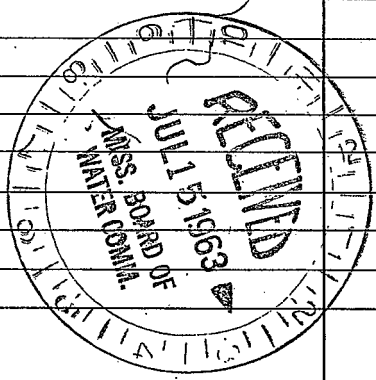

(Use Back Side)

Well No.

5770