

LeFlore
 11-65

MISSISSIPPI BOARD OF WATER COMMISSIONERS

WATER WELL DRILLERS LOG

Date: 11-17-, 1965, Driller: Layne-Central Co. County LeFlore

(Name)

(1) Owner of Land: Greenwood Utilities
 (Name)
Greenwood, Mississippi
 (Address)

(2) Location: 1/4, 1/4, Sec. T R,
 (distance) (direction) (Nearest Town)
_____ miles, of _____,
 (distance) (direction) (Nearest Town)

(3) Topography: _____
 (Hilly) (Flat) (Level)

(4) Purpose of Well: municipal
 (Domestic Irrigation
 Municipal, Industrial, Other)

Description & Color of Materials Sand, Clay, Red Clay, Shell, etc.	Thick- ness Feet	Depth Feet
clay	26	26
sand	16	42
sand & gravel	48	90
sand & stks of clay	38	128
white sand	126	254
clay	51	305
brittle sandy shale	45	350
green sandy shale	111	461
rock	1	462
sandy shale, stks hard		
shale	23	485
fine black sand stks of		
shale & lignite	106	591
clay	4	595
sandy shale	103	698
sand	84	782

Information upon completion of well:

(1) Diameter 12 inches.

(2) Total Depth 762 feet.

(3) Water Level 9' feet below top of ground.

(4) Cased to 700', Size 12"

(5) Screen: Size 8", Length 50'


(6) Were any formations sealed against pollution?
 yes, no.

If YES depth of formation 700'

Why required

Drillers Remarks: _____

co farm.

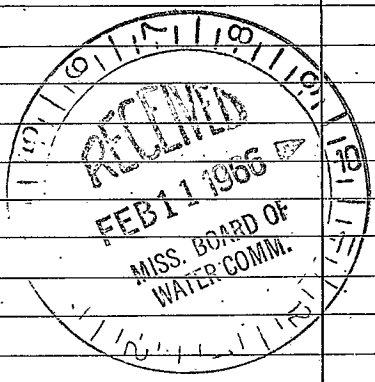

(Use Back Side)

Well No.

