

L

James Ray Life  
WATER WELL DRILLERS LOG

11-18-65

Date: 11-18, 1965, Driller: Frank Taylor, Iron County, Denmark

FARRISH - 453 P 351

(1) Owner of Land: Greenwood Miss  
(Name)  
(Address)

Description & Color of Materials  
Sand, Clay, Red Clay, Shell, etc.

Thick-  
ness  
Feet

Depth  
Feet

<u>Shovel &amp; clay</u>	<u>0</u>	<u>30</u>
<u>Shovel &amp; sand</u>	<u>30</u>	<u>66</u>
<u>Sand</u>	<u>66</u>	<u>80</u>
<u>W sand</u>	<u>80</u>	<u>95</u>

(2) Location: 1/4, 1/4, Sec.     T.     R.      
miles of      
(distance) (direction) (Nearest Town)

(3) Topography: flat  
(Hilly) (Flat) (Level)

(4) Purpose of Well: domestic  
(Domestic Irrigation  
Municipal, Industrial, Other)

Information upon completion of well:

(1) Diameter 2 inches.

(2) Total Depth 95 feet.

(3) Water Level 60 feet below top of ground.

(4) Cased to 85, Size 2"

(5) Screen: Size 1/4, Length 6'

(6) Were any formations sealed against pollution?


    yes,     no.

If YES depth of formation    

Why    

Drillers Remarks:    

230

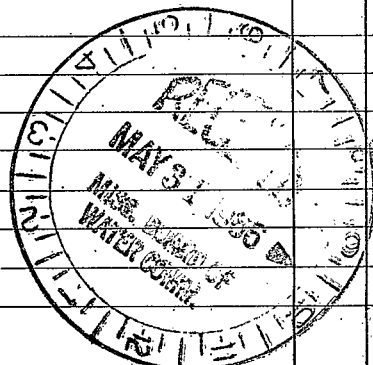

(Use Back Side)

Well No.

