

LEFLORE  
L  
8/12/85

MISSISSIPPI DEPARTMENT OF NATURAL RESOURCES

Bureau of Land and Water Resources

Southport Mall

P.O. Box 10631

Jackson, Mississippi 39209

WATER WELL DRILLERS LOG

8-12  
date well completed

1985 BUTANE GAS COMPANY  
OF GREENWOOD

LEFlore  
county well located

LANDOWNER:

Travelers Ins. Inc.  
916 Hwy 82 Bu Bldg  
Greenwood (mailing address) Mo.

WELL LOCATION:

sec. 33 T 19 N R 1 E  
S W  
2 miles SE of Greenwood  
(distance) (direction) (nearest town)

WELL PURPOSE:

shop  
(home, irrigation, municipal, industrial)

WELL COMPLETION DATA:

- (1) diameter (inches) 4"  
(2) total depth (feet) 100  
(3) static water level (feet) 18 below above  
top of ground.  
(4) casing PVC, 80'  
(material) (depth)  
4" if telescope see back.  
(size)  
(5) screen 20', 80'  
(length) (depth to top)  
4" PVC  
(size) (material)  
(6) pump 1 20  
(HP) (yield gpm)  
Elect.  
(type power)  
(7) electric log No  
(yes or no)  
No  
(organization running log)

- (8) how well bottom plugged  
Bar wash Valve

DRILLERS REMARKS:

Richard Vest

description of formations  
encountered


Clay  
SAND  
sand & gravel  
from 0 8  
8 75  
75 100  
to

RECEIVED  
SEP 3 - 1985

Department of Natural Resources  
Bureau of Land & Water Resources

If well telescopes please  
sketch and show depths.

GROUND LEVEL

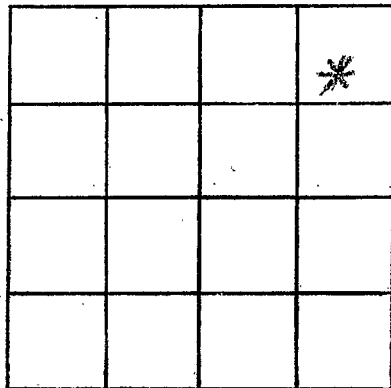

SECTION 33

Please indicate well location X.

ADDITIONAL INFORMATION

If more than one screen,  
show locations of each on sketch.