

LeFlore
L-1
6-59

MISSISSIPPI BOARD OF WATER COMMISSIONERS

WATER WELL DRILLERS LOG

1/9/66

705
CODED

CODED

Date: June 27, 1959, Driller: Layne-Central Company County LeFlore

(Name)

(1) Owner of Land: Greenwood Country Club
(Name)
Greenwood, Mississippi
(Address)

(2) Location: 1/4, 1/4, Sec. 13, 14 T19R1E
1 miles east of Greenwood
(distance) (direction) (Nearest Town)

(3) Topography: flat
(Hilly) (Flat) (Level)

(4) Purpose of Well:
(Domestic Irrigation
Municipal, Industrial, Other)

Description & Color of Materials Sand, Clay, Red Clay, Shell, etc.	Thick- ness Feet	Depth Feet
Surface soil	1	1
Clay	24	25
Muddy sand	35	60
Sand	24	84
Sand & gravel	63	147
Clay	16	163
Sand	21	184
Hard sandy clay	40	224
Sand rock	13	237
Shale strks. sand	43	280
Green sand	20	300
Sand rock	1	301
Shale	24	325
Green sand	13	338
Shale	22	360
Rock	2	362
Shale & rock lens	32	394
Sand strks. shale	12	406
Shale	6	412
Sand strks. shale	22	434
Shale strks. sand	22	456
Hard shale	81	537
Shale strks. sand	100	637
Hard shale	16	653
Sand strks. shale	21	674
HP Sand	4	678
HP Sand	22	700
HP Sand	22	722

Information upon completion of well:

(1) Diameter 8x6x4 inches.

(2) Total Depth 733' 8" feet.

(3) Water Level 14 feet below top of ground.
561' 6"


(4) Cased to 125' 4", Size 8"
inner casing 20' 7" 4"

(5) Screen: Size 4" 2", Length 42' 2"

(6) Were any formations sealed against pollution?
yes yes, no no.

If YES depth of formation outer casing
cemented, lead seal, mechanical
seal and B.P.V.
Why _____

Drillers Remarks: 707
42
751
20

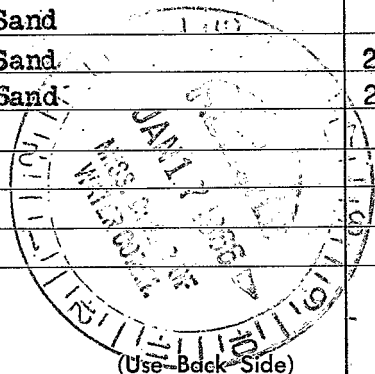

Well No.

1900

1900

1900

1900