

Lefflore
L-3
5-11-60

MISSISSIPPI BOARD OF WATER COMMISSIONERS

WATER WELL DRILLERS LOG

11/12/65
618
CODED

Date: May 11, 19 60, Driller: Layne-Central Company Lefflore

(Name)

School
(1) Owner of Land: Lefflore County High
(Name)
Greenwood, Mississippi
(Address)

(2) Location: 1/4, 1/4, Sec. 19 T9 R15,
1 miles south of Greenwood,
(distance) (direction) (Nearest Town)

(3) Topography: flat
(Hilly) (Flat) (Level)

(4) Purpose of Well: domestic
(Domestic Irrigation
Municipal, Industrial, Other)

Description & Color of Materials Sand, Clay, Red Clay, Shell, etc.	Thick- ness Feet	Depth Feet
Clay	12	12
Sand & gravel	7	19
Coarse sand	61	80
Coarse sand & pea gravel	44	124
Clay, strks. sand	55	179
White sand	51	230
Clay	56	286
Rock	1	287
Fine sand & strks. clay	101	388
Clay with strks. sand	132	520
Clay	30	550
Fine sand, strks. clay	132	682
Clay	17	699
Sand (bottom)	65	764

Information upon completion of well:

(1) Diameter 8x4 inches.

(2) Total Depth 764 feet.

(3) Water Level flowing feet below top of ground.

(4) Cased to 103', Size 8",
296' 4"
14' lap

(5) Screen: Size 4", Length 40'
10' of 4" blank.
1' of 8" x 6" swage.

(6) Were any formations sealed against pollution?
yes yes, no no.

If YES depth of formation Mechanical seal,
Cement plug and shot bottom.


Why

Drillers Remarks:

200 GPM.

Electric power.

CODED

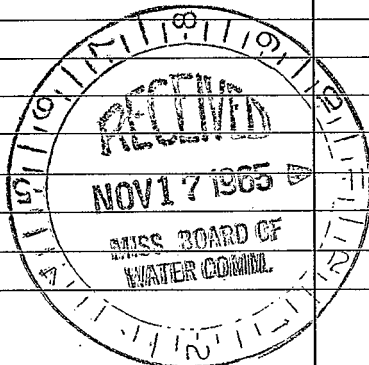

(Use Back Side)

Well No.

100