

L-14

8-31-60

WATER WELL DRILLERS LOG

L-302

CODED

Date: AUG. 31, 1960, Driller: DELTA DRILLING CO. County LEFLORE

2906 2910

(Name)

(1) Owner of Land: MRS. HAZEL ROBERTS

(Name)

PT. #1, BOX 78, GREENWOOD, MISS.

(Address)

(2) Location: 1/4, 1/4, Sec. 25 T19 R1E

1/4 miles SE, of GREENWOOD,
(distance) (direction) (Nearest Town)

(3) Topography:

(Hilly) (Flat) (Level)

(4) Purpose of Well: DOMESTIC

(Domestic Irrigation
Municipal, Industrial, Other)

Description & Color of Materials
Sand, Clay, Red Clay, Shell, etc.

Thick-
ness
Feet

Depth
Feet

SAND

86

86

GRAVEL

42

128'

SAND

87

215

GUMBO & SHALE w/ 1/2" ROCK

42

257

GREEN SAND

28

285

SHALE

14

299

SAND

26

325

SHALE

13

338

GREEN SAND

92'-8"

430'-8"

Information upon completion of well:

(1) Diameter 2 inches.

(2) Total Depth 430' feet. 8"

(3) Water Level _____ feet below top of ground.

(4) Cased to 430, Size 2

(5) Screen: Size 2" PERFORATED
PIPE, Length 40'

(6) Were any formations sealed against pollution?


_____ yes, _____ no.

If YES depth of formation _____

Why _____

Drillers Remarks: _____

CODED

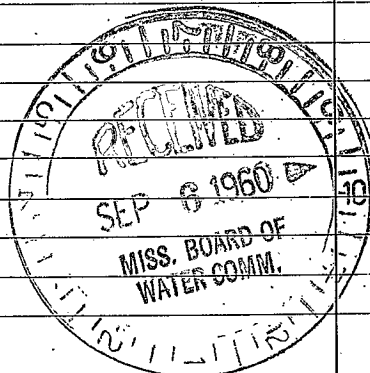

(Use Back Side)

Well No.

03012

03012