

LeFlore
6-18
9-12-61

MISSISSIPPI BOARD OF WATER COMMISSIONERS

WATER WELL DRILLERS LOG

²⁰⁸
CODED

Date: SEPT. 12, 1961, Drillers: DELTA DRILLING Co. County LEFLORE
(Name)

	Description & Color of Materials Sand, Clay, Red Clay, Shell, etc.	Thick- ness Feet	Depth Feet
(1) Owner of Land: <u>GEORGE YOUNG</u> (Name)	GUMBO -	34	34
<u>HIGHWAY 82 E, GREENWOOD, MISS</u> (Address)	SAND	50	84
(2) Location: <u>1/4, 1/4, Sec. 17 T. 19 R. 2 E.</u>	GRAVEL	22	106
_____ miles _____ of _____ (distance) (direction) (Nearest Town)	GUMBO	52	158
(3) Topography: _____ (Hilly) (Flat) (Level)	GREEN SAND w/15" ROCK	81	239
(4) Purpose of Well: <u>DOMESTIC</u> (Domestic Irrigation Municipal, Industrial, Other)	SANDY GUMBO	76	315
	GREEN SAND w/16" ROCK	136	451
	SHALEY GUMBO -	97	528
	SHALE	87	615
	SANDY SHALE	85	700
	WHITESAND	25	725


Information upon completion of well:

- (1) Diameter 3 inches.
- (2) Total Depth 725 feet.
- (3) Water Level WELL FLOWS feet below top of ground.
- (4) Cased to 725', Size 3" 400', 2" 325'
- (5) Screen: Size 2", Length 20
- (6) Were any formations sealed against pollution?
_____ yes, _____ no.

If YES depth of formation _____
Why _____

Drillers Remarks: 20' LAP OF 2" IN 3"
PIPE - WELL FLOWS 55 GPM

CODED

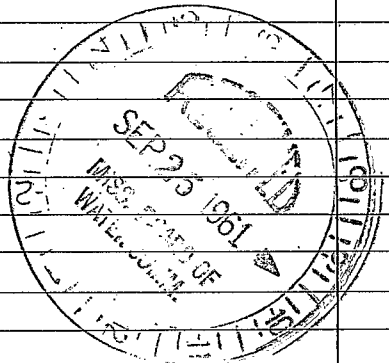

(Use Back Side)

Well No.

1947

1947