

LEFLORE

L 20

1-72

MISSISSIPPI
 BOARD OF WATER COMMISSIONERS
 416 North State Street
 Jackson, Mississippi 39201

WATER WELL DRILLERS LOG

19 BUTANE GAS CO. OF GREENWOOD Leflore
 date well completed firm name county well located

LANDOWNER:

John Hughes

Greenwood
 (mailing address)

WELL LOCATION:

sec. 32 T. 19 N. R. 1 E.
7 miles SW of Greenwood
 (distance) (direction) (nearest town)

WELL PURPOSE: Home
 (home, irrigation, municipal, industrial)

WELL COMPLETION DATA:

- (1) diameter (inches) 4x2
- (2) total depth (feet) 797
- (3) static water level (feet) 10 below top of ground. above
- (4) casing Steel, 777,
 (material) (depth)
4x2 if telescope see back.
 (size)
- (5) screen 20, 777
 (length) (depth to top)
2", Stainless
 (size) (material)
- (6) pump 2, 20
 (HP) (yield gpm)
Elec
 (type power)
- (7) electric log NO
 (yes or no)

(organization running log)

(8) how well bottom plugged
Lead Plug

description of formations encountered

from to

CLAY	0	30
SAND + GRAVEL	30	80
COARSE SAND + GRAVEL	80	220
CLAY	220	250
SAND	250	310
CLAY	310	400
SAND	400	460
SHALE	460	750
SAND - white	750	797

CODED

FEB 20 1973

DRILLERS REMARKS:


If well telescopes please sketch and show depths.

GROUND LEVEL

105' - 4" CASING →

~~672'~~
672' - 2" CASING →

20' - 2" SCREEN →

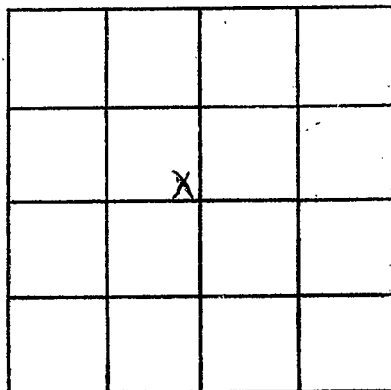

SECTION 32

Please indicate well location X.

ADDITIONAL INFORMATION

If more than one screen, show locations of each on sketch.