

L-21
6-22-63

WATER WELL DRILLERS LOG

CODED

Date: JUNE 22, 1963, Driller: DELTA DRILLING Co. County LEFFLORE

(Name)


- (1) Owner of Land: G. C. MANTOY
(Name)
GREENWOOD, MISS.
(Address)
- (2) Location: 1/4, 1/4, Sec. 17 T20R2E,
_____ miles _____ of _____
(distance) (direction) (Nearest Town)
- (3) Topography: _____
(Hilly) (Flat) (Level)
- (4) Purpose of Well: _____
(Domestic Irrigation, Municipal, Industrial, Other)

Description & Color of Materials Sand, Clay, Red Clay, Shell, etc.	Thick- ness Feet	Depth Feet
SAND	94	94
GRAVEL	67	161
SAND	128	289
GUMBO	60	349
GREEN SAND	91	440
SHALE	40	480
GREEN SAND	30	510
GUMBO	18	528
SHALE	42	570
GREEN SAND	16	586
GUMBO	36	612
SHALE	62	674
SAND	78	752
SHALE	68	820
SAND	89	909

Information upon completion of well:

- (1) Diameter 4 inches.
- (2) Total Depth 909 feet.
- (3) Water Level WELL FLOWS feet below top of ground.
- (4) Cased to 889, Size 500' 4" 4" 10' - 2 1/2"
- (5) Screen: Size 2 1/2, Length 20
- (6) Were any formations sealed against pollution?
_____ yes, _____ no.

CODED

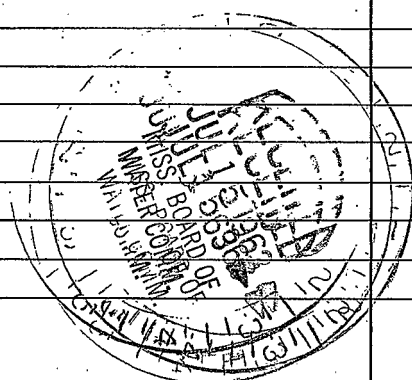

(Use Back Side)

Well No.

