

L-23  
11-15-63

WATER WELL DRILLERS LOG

**CODED**

Date: NOV. 15, 1963, Driller: DELTA DRILLING Co County: EFFLORE  
(Name)

(1) Owner of Land: C.E. BURNS  
SUB-DIVISION (Name)  
GREENWOOD MISS.  
(Address)

(2) Location: 1/4, 1/4, Sec. 24 T19R1E,  
\_\_\_\_\_ miles \_\_\_\_\_ of \_\_\_\_\_  
(distance) (direction) (Nearest Town)

(3) Topography: \_\_\_\_\_  
(Hilly) (Flat) (Level)

(4) Purpose of Well: DOMESTIC  
(Domestic Irrigation  
Municipal, Industrial, Other)

Description & Color of Materials Sand, Clay, Red Clay, Shell, etc.	Thick- ness Feet	Depth Feet
GUMBO	50	50
SAND	30	80
GRAVEL	45	120
SAND	40	160
GUMBO	30	190
SHALE	60	250
SAND	40	290
SHALE	82	372
SAND W/ROCKS-	29	401
SHALE	41	442
GREEN SAND	30	472
SHALE W/ROCKS-	50	522
SAND W/ROCKS-	36	558
SHALE	54	612
SAND	30	642
SHALE	40	682
SAND	60	742

**CODED**

Information upon completion of well:

(1) Diameter 4" inches.

(2) Total Depth 742 feet.

(3) Water Level WELL FLOWS feet below top of ground.


(4) Cased to 722, Size 420'-4" / 320'-2 1/2"

(5) Screen: Size 2 1/2, Length 18'

(6) Were any formations sealed against pollution?  
\_\_\_\_\_ yes, \_\_\_\_\_ no.

If YES depth of formation \_\_\_\_\_  
Why \_\_\_\_\_

Drillers Remarks: 18' LAP OF 2 1/2"  
IN 4" PIPE =

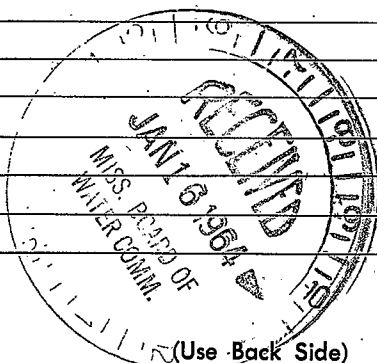

Well No.

✓

1000

1000