

LeFlore MISSISSIPPI BOARD OF WATER COMMISSIONERS

L-28  
7-31-65

WATER WELL DRILLERS LOG

**CODED**

Date: JULY 31, 1965, Driller: DELTA DRILLING Co. County LEFLORE  
(Name)

(1) Owner of Land: GEORGE YOUNG  
(Name)  
GREEN WOOD, MISS  
(Address)

(2) Location: 1/4, 1/4, Sec. 13 T19R1E,  
\_\_\_\_\_ miles \_\_\_\_\_ of \_\_\_\_\_  
(distance) (direction) (Nearest Town)

(3) Topography: \_\_\_\_\_  
(Hilly) (Flat) (Level)

(4) Purpose of Well: DOMESTIC  
(Domestic Irrigation  
Municipal, Industrial, Other)

Description & Color of Materials Sand, Clay, Red Clay, Shell, etc.	Thick- ness Feet	Depth Feet
TOP SOIL & SAND	62	62
GRAVEL	60	122
SAND	22	144
GUMBO	56	200
GREEN SAND W/ ROCKS	45	245
SHALE	40	285
GREEN SAND	63	348
SHALE	65	413
GREEN SAND	12	425
SHALE	30	455
SAND	18	473
SHALE	52	525
GREEN SAND	32	587
WHITE SAND	94	681
SHALE	28	709

Information upon completion of well:

(1) Diameter 4 inches.

(2) Total Depth 709 feet.

(3) Water Level FLWS feet below top of ground.

(4) Cased to 689, Size 4 + 2 1/2


(5) Screen: Size 2 1/2", Length 20'

(6) Were any formations sealed against pollution?  
\_\_\_\_\_ yes, \_\_\_\_\_ no.

If YES depth of formation \_\_\_\_\_  
Why \_\_\_\_\_

Drillers Remarks: 21' LAP OF 2 1/2"  
IN 4" PIPE - 30' - 2 1/2" PIPE  
ON BOTTOM OF WELL

**CODED**

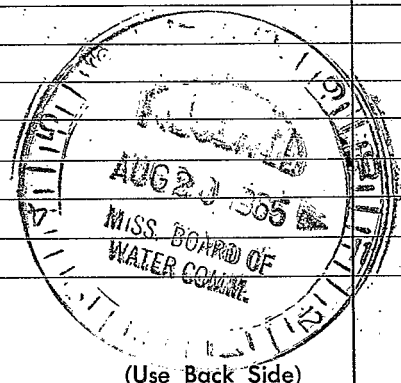

(Use Back Side)

Well No.

1000  
1000