

Letlore
L-29

MISSISSIPPI BOARD OF WATER COMMISSIONERS

2-10-66

WATER WELL DRILLERS LOG

CODED

Date: 2-10, 1966, Driller: Barton Barb J B - worde County: Flow
(Name)

(1) Owner of Land: DICIE COLVIN
(Name)
GREENWOOD, MISS.
(Address)

(2) Location: 1/4, 1/4, Sec. 10 T19 R1E,
4 miles EAST of GREENWOOD
(distance) (direction) (Nearest Town)

(3) Topography: FLAT
(Hilly) (Flat) (Level)

(4) Purpose of Well: DOMESTIC
(Domestic Irrigation
Municipal, Industrial, Other)

Description & Color of Materials Sand, Clay, Red Clay, Shell, etc.	Thick- ness Feet	Depth Feet
0-10 SAND	10	10
30 CLAY	20	30
80 SAND	50	80
130 GRAVEL	50	130
210 GRAVEL	80	210
490 SHALE SAND	280	490
570 SHALE CLAY	80	570
620 SAND	50	620
BOTTOM OF WELL 608'		

Information upon completion of well:

(1) Diameter 2" inches.

(2) Total Depth 608 feet.

(3) Water Level Flow feet below top of ground.

(4) Cased to 588', Size 2"

(5) Screen: Size 2", Length 20'

(6) Were any formations sealed against pollution?

yes, X no.

If YES depth of formation _____

Why _____


Drillers Remarks: _____

Yield in G. P. M.: 12

Type power: ELECTRIC

Crops irrigated & Acreage: NONE

CODED

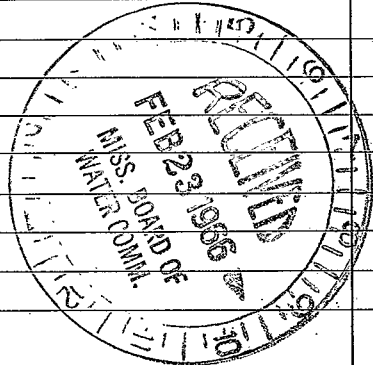

(Use Back Side)

Well No.

100