

Leflore
 L 33
 3-16-65

WATER WELL DRILLERS LOG

Date: MAR 16, 1965, Drillers: DELTA DRILLING Co. County LEFLORE

(Name)

(1) Owner of Land: R. W. DAVES-
 (Name)

GREENWOOD, MISS-
 (Address)

(2) Location: NW 1/4, NW 1/4, Sec. 11 TENN. RIV.

_____ miles _____ of _____
 (distance) (direction) (Nearest Town)

(3) Topography: _____
 (Hilly) (Flat) (Level)

(4) Purpose of Well: SUBDIVISION
 (Domestic Irrigation
 Municipal, Industrial, Other)

Information upon completion of well:

(1) Diameter 4 inches.

(2) Total Depth 801 feet.

(3) Water Level FLOWS feet below top of ground.

(4) Cased to 781', Size 4" 105'
3" 399'
2" 305'

(5) Screen: Size 2", Length 20'

(6) Were any formations sealed against pollution?
 _____ yes, _____ no.


If YES depth of formation _____

Why _____

Drillers Remarks: 27' LAP OF 2" IN 3" PIPE - 11' 2" TAIL PIPE ON BOTTOM END OF WELL -

Description & Color of Materials Sand, Clay, Red Clay, Shell, etc.	Thick-ness Feet	Depth Feet
<u>GUMBO</u>	<u>22</u>	<u>22</u>
<u>SAND</u>	<u>43</u>	<u>65</u>
<u>GRAVEL</u>	<u>83</u>	<u>148</u>
<u>SAND</u>	<u>45</u>	<u>193</u>
<u>GUMBO</u>	<u>61</u>	<u>254</u>
<u>SHALE W/ROCKS</u>	<u>20</u>	<u>274</u>
<u>GREEN SAND</u>	<u>62</u>	<u>336</u>
<u>SHALE</u>	<u>42</u>	<u>378</u>
<u>GREEN SAND</u>	<u>38</u>	<u>416</u>
<u>SHALE</u>	<u>77</u>	<u>493</u>
<u>GUMBO</u>	<u>39</u>	<u>532</u>
<u>GREEN SAND</u>	<u>80</u>	<u>612</u>
<u>SHALE</u>	<u>40</u>	<u>652</u>
<u>GUMBO</u>	<u>62</u>	<u>714</u>
<u>SHALE</u>	<u>42</u>	<u>756</u>
<u>SAND</u>	<u>45</u>	<u>801</u>

Coded

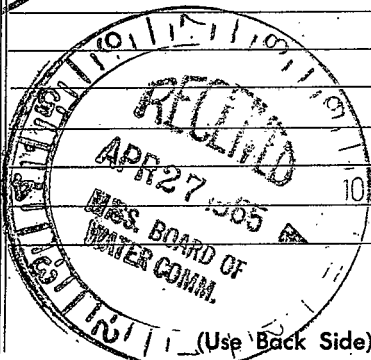

Well No.

[The page contains extremely faint and illegible text, likely bleed-through from the reverse side of the document. No specific words or phrases can be discerned.]