

MISSISSIPPI BOARD OF WATER COMMISSIONERS

WATER WELL DRILLERS LOG

CODED

Date: 12-28, 1964, Driller: DELTA DRILLING Co. County: DELORE

(Name)

CODED

CHAPMAN BROS &

(1) Owner of Land: G. C. FREDERICK

(Name)

RTE 2, GREENWOOD, MISS

(Address)

(2) Location: 1/4, 1/4, Sec. 1 T19R1E

 miles of
(distance) (direction) (Nearest Town)

(3) Topography:

(Hilly) (Flat) (Level)

(4) Purpose of Well: SUB-DIVISION

(Domestic Irrigation
Municipal, Industrial, Other)

Description & Color of Materials Sand, Clay, Red Clay, Shell, etc.	Thick- ness Feet	Depth Feet
TOP SOIL & SAND-	50	50
GUMBO	16	66
SAND	16	82
GRAVEL	74	156
SAND	22	178
GUMBO W/ROCK	52	230
SHALE	42	272
GREEN SAND W/ROCKS	40	312
SHALE W/ROCK	41	353
SAND W/ROCK	22	375
SHALE	114	489
GUMBO	20	509
SHALE	60	569
SAND	26	595
SHALE	20	615
SAND	20	635
SHALE	15	650
WHITE SAND	59	709

Information upon completion of well:

(1) Diameter 4 inches.

(2) Total Depth 709 feet.

(3) Water Level FLOWS feet below top of ground.

(4) Cased to 689, Size 4"-3" & 2"

(5) Screen: Size 2", Length 20'

(6) Were any formations sealed against pollution?

 yes, no.


If YES depth of formation

Why

Drillers Remarks: 20' LAP OF 2" IN

3" PIPE

CODED

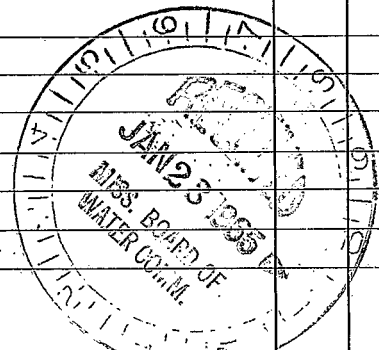

(Use Back Side)

Well No.

... ..

...

... ..

... ..

