

Leflore

MISSISSIPPI BOARD OF WATER COMMISSIONERS

QL-38

9-21-56

WATER WELL DRILLERS LOG

4/15/65
279

Date: Sept. 21, 1956, Driller: Layne-Central Company County Leflore

(Name)

(1) Owner of Land: C. S. Whittington

Pee Dee Plantation

Greenwood, Mississippi

(Address)

28, 29, 31,

(2) Location: 1/4, 1/4, Sec. 32, 33 T 19 R 1E

6 miles west of Schlater
(distance) (direction) (Nearest Town)

(3) Topography: flat

(Hilly) (Flat) (Level)

(4) Purpose of Well: irrigation

(Domestic Irrigation
Municipal, Industrial, Other)

Information upon completion of well:

(1) Diameter 16x12 inches.

(2) Total Depth 92 feet.

(3) Water Level 18' - 6" feet below top of ground.

(4) Cased to 50', Size 16"
2' swage

(5) Screen: Size 12", Length 40'

(6) Were any formations sealed against pollution?

no yes, no no.

If YES depth of formation _____

Why _____

Drillers Remarks: _____


2461 GPM

electric motor

Description & Color	Thickness feet	Depth Feet
Clay	28	28
Fine sand	10	38
Fine sand	4	42
Coarse sand & pea gravel	30	72
Sand & gravel	10	82
Sand & gravel	7	89
Gravel & sand rock	10	92

CODED

CODED

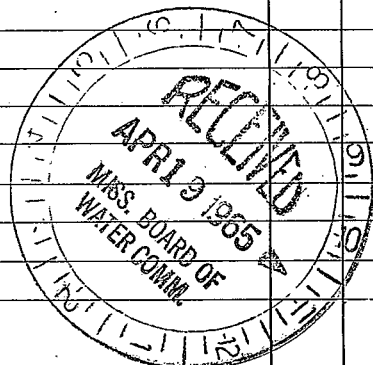

(Use Back Side)

Well No.

