

Leflore
 OL-39
 5-31-57

MISSISSIPPI BOARD OF WATER COMMISSIONERS

CODED

11/24/65
 Jpr
 430

WATER WELL DRILLERS LOG

Date: May 31, 19 57, Driller: Layne-Central Company County Leflore

(Name)

(1) Owner of Land: C. S. Whittington
 Fullbright Place (Name)
Greenwood, Mississippi

(Address) 28, 29, 31, 32, 33 / 9 1E

(2) Location: 1/4, 1/4, Sec. T R

10 miles northwest, of Schlater
 (distance) (direction) (Nearest Town)

(3) Topography: flat
 (Hilly) (Flat) (Level)

(4) Purpose of Well: irrigation
 (Domestic Irrigation
 Municipal, Industrial, Other)

Description & Color of Materials Sand, Clay, Red Clay, Shell, etc.	Thick- ness Feet	Depth Feet
Clay	18	18
Blue clay	4	22
Fine blue sand	22	44
Coarse sand & gravel	6	52
Sand & gravel	10	62
Coarse sand	20	82
Sand & pea rock	10	92
Sand & big gravel	11	103
Rock	2	104
Pea rock & gravel	7	111

Information upon completion of well:

(1) Diameter 18x12 inches.

(2) Total Depth 111 feet.

(3) Water Level 15' 3" feet below top of ground.

(4) Cased to 56', Size 18"
5' of 18" x 12" swage

(5) Screen: Size 12", Length 50'

(6) Were any formations sealed against pollution?

no yes, no no.


If YES depth of formation _____

Why _____

Drillers Remarks: _____

2487 GPM.

Electric power.

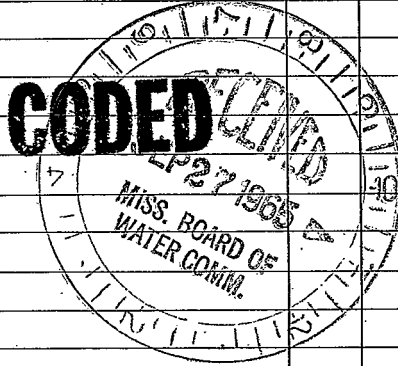

(Use Back Side)

Well No.

1917

[The remainder of the page contains extremely faint and illegible text, likely bleed-through from the reverse side of the document.]