

Leflore
L-41
4-10-58

MISSISSIPPI BOARD OF WATER COMMISSIONERS

WATER WELL DRILLERS LOG

10/11/65
532

Date: April 10, 1958, Driller: Layne-Central Company Leflore

(Name)

CODED

(1) Owner of Land: C. S. Whittington
(Name)

Greenwood, Mississippi
(Address)

(2) Location: 1/4, 1/4, Sec. 31 T19R2E
Sidon, Mississippi
4 miles southeast, of Greenwood
(distance) (direction) (Nearest Town)

(3) Topography: flat
(Hilly) (Flat) (Level)

(4) Purpose of Well: irrigation
(Domestic Irrigation
Municipal, Industrial, Other)

Description & Color of Materials Sand, Clay, Red Clay, Shell, etc.	Thick- ness Feet	Depth Feet
Clay	26	26
Fine blue sand	10	36
Coarse sand	18	54
Sand & pea rock	13	67
Coarse sand	6	83
Sand & pea rock	9	92
Sand & gravel	10	102
Sand & gravel	9	111
Clue clay	1	112

Information upon completion of well:

- (1) Diameter 16x12 inches.
- (2) Total Depth 111 feet.
- (3) Water Level 18' 3" feet below top of ground.
- (4) Cased to 68' Size 16"
2' of 16" x 12" swage
- (5) Screen: Size 12", Length 40'
- (6) Were any formations sealed against pollution?
_____ yes, _____ no no.


If YES depth of formation _____

Why _____

Drillers Remarks:

2000 GPM.

CODED

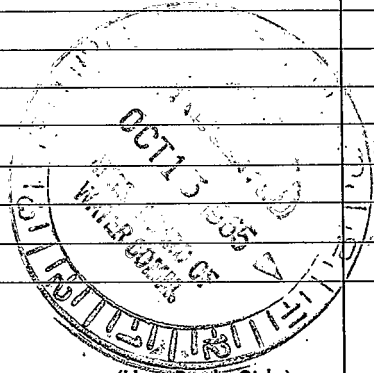

(Use Back Side)

Well No.

