

LEFLORE
L 52
9-28-72

MISSISSIPPI
 BOARD OF WATER COMMISSIONERS
 416 North State Street
 Jackson, Mississippi 39201

CODED

WATER WELL DRILLERS LOG

BUTANE GAS CO. OF GREENWOOD Leflore

9-28-72 19 firm name county well located

LANDOWNER:
Noel Myers
Greenwood
 (mailing address)

description of formations encountered	from	to
CLAY	0	30
SAND	30	50
SAND + GRAVEL	50	130
CLAY	130	200
SAND + SHALE	200	380
SAND	380	417

WELL LOCATION:
 sec. 12 T. 14 N R. 1 E
 S. 4 W
1/2 miles NE of Greenwood
 (distance) (direction) (nearest town)

WELL PURPOSE: Home
 (home, irrigation, municipal, industrial)

WELL COMPLETION DATA:

(1) diameter (inches) 2"

(2) total depth (feet) 417

(3) static water level (feet) 10 ^{below} above top of ground.

(4) casing PVC, 397,
 (material) (depth)
2"
 (size) if telescope see back.

(5) screen 20', 397
 (length) (depth to top)
2", stainless
 (size) (material)

(6) pump 1/2, 10
 (HP) (yield gpm)
Elec
 (type power)

(7) electric log N
 (yes or no)

(organization running log)

CODED

OCT 5 1972


MISS. DE. OF
 WATER BOARD

(8) how well bottom plugged
Back Pressure Valve

DRILLERS REMARKS:

If well telescopes, please sketch and show depths.

GROUND LEVEL

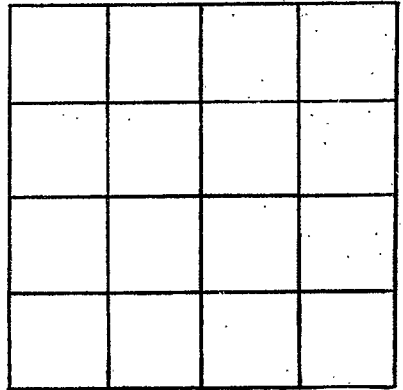

SECTION _____

Please indicate well location X.

ADDITIONAL INFORMATION

If more than one screen,
show locations of each on sketch.