

LEFLORE

L 53

9-21-72

MISSISSIPPI
 BOARD OF WATER COMMISSIONERS
 416 North State Street
 Jackson, Mississippi 39201

WATER WELL DRILLERS LOG

9-21 date well completed

1972 DYER WELL & IRRIGATION SERVICE

firm name

WELL LOCATED

LANDOWNER: R.L. STIBLER

description of formations encountered

from

to

PAT Drive INN

GREENWOOD, MISSISSIPPI
(mailing address)

WELL LOCATION:

sec. 22 T. 19 N. R. 1 E
 1 miles So. of Greenwood
 (distance) (direction) (nearest town)

WELL PURPOSE: MOVIE
(home, irrigation, municipal, industrial)

WELL COMPLETION DATA:

- (1) diameter (inches) 4" x 2"
- (2) total depth (feet) 378'
- (3) static water level (feet) 3' below above top of ground.
- (4) casing P.V.C. 4" x 2" (material) 378' (depth)
- (5) screen 10' 378' (length) (depth to top)
2" STAINLESS STEEL (size) (material)
- (6) pump 1/2 10 (HP) (yield gpm)
ELEC. (type power)
- (7) electric log N/O. (yes or no)
- (8) how well bottom plugged B.P.V.

DRILLERS REMARKS:

description of formations encountered	from	to
CLAY	0	18
SAND	18	80
SAND & GRAVEL	80	170
CLAY	170	185
SHALE & SAND ST.	185	293
SHALE	293	322
SHALE & ROCK ST.	322	334
SHALE	334	370
SANDY SHALE	370	382
SAND	382	402

COVERED


OCT 17 1972

MISS. GEOL. SURV.
FLOOR 1000

If well telescopes please sketch and show depths.

GROUND LEVEL

84 FT - 4" TOP CASING
294 FT - 2" LOWER CASING
10 FT - 2" SCREEN ALL
DIRECT COMPLET

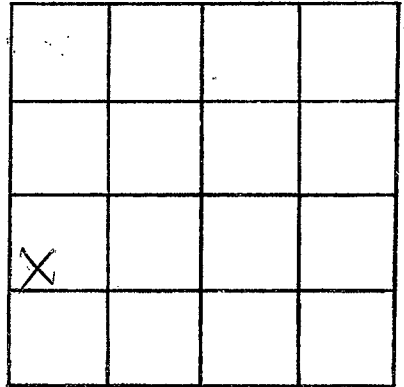

SECTION 22

Please indicate well location X.

ADDITIONAL INFORMATION

If more than one screen,
show locations of each on sketch.