

**LEFLORE**  
**L67**  
**3-24-73**

MISSISSIPPI  
 BOARD OF WATER COMMISSIONERS  
 416 North State Street  
 Jackson, Mississippi 39201

**CODED**

**WATER WELL DRILLERS LOG**

March 24 19 73 date well completed  
 DYER WELL & IRRIGATION SERVICE firm name  
 LEFLORE county well located

LANDOWNER: LeFlore Co. School

description of formations encountered

GREENWOOD  
Miss  
 (mailing address)

description of formations encountered	from	to
CLAY	0	26
SAND	26	60
SAND & GRAVEL	60	115
CLAY	115	131
CLAY & SAND ST.	131	182
SAND	182	258
SANDY SHALE	258	330
CLAY	330	380
SAND CLAY	380	430
SAND	430	488
CLAY	488	502
SHALE SAND ROCK	502	602
SAND & SHALE	602	662
SHALE	662	715
SAND	715	723
SHALE	723	730
SAND	730	762
SHALE	762	780
SAND	780	811

WELL LOCATION:  
 sec 30 T 19 N R 1 E  
2 miles S of G-WOOD  
 (distance) (direction) (nearest town)

WELL PURPOSE: SCHOOL  
 (home, irrigation, municipal, industrial)

WELL COMPLETION DATA:

- (1) diameter (inches) 6" x 4"
- (2) total depth (feet) 811'
- (3) static water level (feet) Flow below top of ground.
- (4) casing BUT IR 771' (material) (depth)  
186'-6" 585'-4" if telescope see back.  
 (size)
- (5) screen 40' 771' (length) (depth to top)  
2" STAINLESS STEEL (size) (material)
- (6) pump 7 1/2 100 (HP) (yield gpm)  
EVOL (type power)
- (7) electric log N/D (yes or no)  
 (organization running log)
- (8) how well bottom plugged F.P.V.


DRILLERS REMARKS:

JUN 27 1973

If well telescopes please sketch and show depths.

GROUND LEVEL

6" DIRECT COUPLED  
WITH SWAGE  
NIPPLE

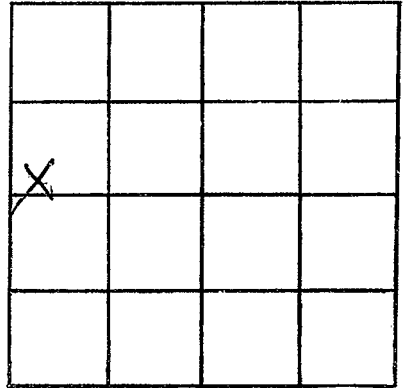

SECTION 34

Please indicate well location X.

ADDITIONAL INFORMATION

If more than one screen,  
show locations of each on sketch.