

**LEFLORE**  
**L69**  
**5-21-74**

MISSISSIPPI  
 BOARD OF WATER COMMISSIONERS  
 416 North State Street  
 Jackson, Mississippi 39201

**CODED**

**WATER WELL DRILLERS LOG**

May 21 1974 BRUCE BERRYMAN Leflore  
 date well completed firm name county well located  
 Greenwood

LANDOWNER:	description of formations encountered	from	to
Jessie Hemphill Sr.	Clay	0	10
Hwy 82E. Greenwood,	Sand	10	30
Miss. 38930 (mailing address)	Clay	30	60
<b>WELL LOCATION:</b>	Sand & Gravel	60	110
sec. 20 T. 19 N. R. 2 E	Clay	110	170
3 miles East of Greenwood	Rock	170	171
(distance) (direction) (nearest town)	Clay	171	185
<b>WELL PURPOSE:</b> Home	Green sand	185	195
(home, irrigation, municipal, industrial)	Clay	195	205
<b>WELL COMPLETION DATA:</b>	Sandy clay	205	229
(1) diameter (inches) 2"	Sand	229	240
(2) total depth (feet) 388'	Shale & sand	240	260
(3) static water level (feet) Flow below top of ground.	Shale	260	290
(4) casing 2" galv. pipe - 378'	Sand	290	305
(material) (depth)	Shale	305	318
(size) if telescope see back.	Rock	318	319
(5) screen 10' .010 378'	Sandy shale	319	347
(length) (depth to top)	Sand	347	355
2" stainless steel	Shale /str. sand	355	370
(size) (material)	Sand	370	405
(6) pump 1/2 19	Clay	405	410
(HP) (yield gpm)			
Electric			
(type power)			
(7) electric log No			
(yes or no)			
(organization running log)			
(8) how well bottom plugged B.P.V.			
<b>DRILLERS REMARKS:</b>			


**CODED**

MAY 22 1974

MISSISSIPPI BOARD OF WATER COMMISSIONERS

If well telescopes please sketch and show depths.

GROUND LEVEL

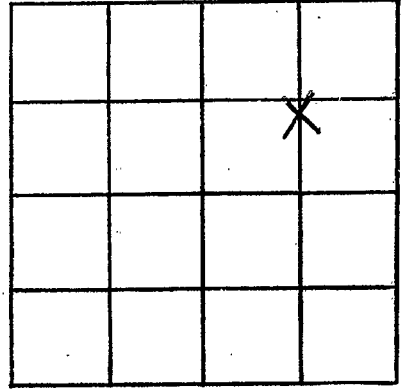

SECTION 20

Please indicate well location X.

ADDITIONAL INFORMATION

If more than one screen, show locations of each on sketch.