

LEFLORE
L 71
5-23-74


MISSISSIPPI
 BOARD OF WATER COMMISSIONERS **CODED**
 416 North State Street
 Jackson, Mississippi 39201

WATER WELL DRILLERS LOG

May 23 19 74 BRUCE BERRYMAN Leflore
 date well completed Greenwood, Miss county well located

LANDOWNER: <u>Jessie Hemphill Jr</u>	description of formations encountered	from	to
<u>Browning Road,</u>	Clay	0	40
<u>Greenwood, Miss. 38930</u>	Sand	40	150
<u>(mailing address)</u>	Clay	150	190
WELL LOCATION:	Rock	190	191
sec. <u>6</u> T <u>19</u> N R <u>2</u> E	Clay	191	220
<u>3</u> miles N.E. <u>Greenwood</u>	Sandy Clay	220	240
(distance) (direction) of (nearest town)	Sandy shale	240	300
WELL PURPOSE: <u>Home</u>	Clay	300	320
(home, irrigation, municipal, industrial)	Sand	320	335
WELL COMPLETION DATA:	Clay	335	340
(1) diameter (inches) <u>2"</u>	Sandy shale	340	360
(2) total depth (feet) <u>388'</u>	Sand & clay st.	360	380
(3) static water level (feet) <u>3'</u> below above top of ground.	Sand	380	397
(4) casing <u>2" galv. pipe - 378'</u>	Clay	397	400
(size) if telescope see back.			
(5) screen <u>10' .010 378'</u>			
(length) (depth to top)			
<u>2" Stainless steel</u>			
(size) (material)			
(6) pump <u>1/2 19</u>			
(HP) (yield gpm)			
<u>Electric</u>			
(type power)			
(7) electric log <u>No</u>			
(yes or no)			
<u>(organization running log)</u>			
(8) how well bottom plugged <u>B.P.V.</u>			
DRILLERS REMARKS:			

CODED

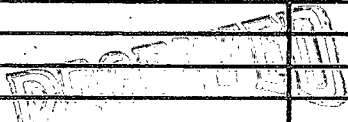


MAY 26 1974

MISSISSIPPI BOARD OF WATER COMMISSIONERS

If well telescopes please sketch and show depths.

GROUND LEVEL

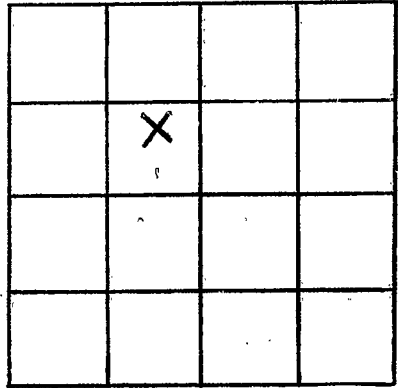

SECTION 6

Please indicate well location X.

ADDITIONAL INFORMATION

If more than one screen,
show locations of each on sketch.

11