

**LEFLORE**  
 L 72  
 774

MISSISSIPPI  
 BOARD OF WATER COMMISSIONERS  
 416 North State Street  
 Jackson, Mississippi 39201 **CODED**

**WATER WELL DRILLERS LOG**

July 19 74 JACK MARTIN Well Serv. Leflore  
 date well completed firm name county well located

LANDOWNER: C & R Const. Co.  
 Greenwood, Ms.  
 Sec. 24 19W 1E  
 (mailing address)

WELL LOCATION:  
 ON Highway 224  
 224 miles South of Greenwood  
 (distance) (direction) (nearest town)

WELL PURPOSE: INDUSTRIAL  
 (home, irrigation, municipal, industrial)

- WELL COMPLETION DATA:
- (1) diameter (inches) 4" x 2"
  - (2) total depth (feet) 600'
  - (3) static water level (feet) Flows below top of ground.
  - (4) casing Steel, 560' (material), (depth), 4" x 2" (size) If telescope see back.
  - (5) screen 40' (length), 560' (depth to top), 2" (size), Stainless Steel (material)
  - (6) pump 1 (HP), 15 (yield gpm), Elec (type power)
  - (7) electric log no (yes or no)
  - (organization running log)
  - (8) how well bottom plugged CAP

description of formations encountered	from	to
Clay	0	12
Sand + GRAVEL	12	148
Mud	148	238
Green Sand	238	339
Sand, Mud, & Rock layers	339	485
Layers of Sand + Shale	485	535
Sand	535	600
<b>CODED</b>		


**RECEIVED**  
 JUL 25 1974

MISS. BD. OF WATER COMMISSIONERS

DRILLERS REMARKS:

If well telescopes please sketch and show depths.

GROUND LEVEL

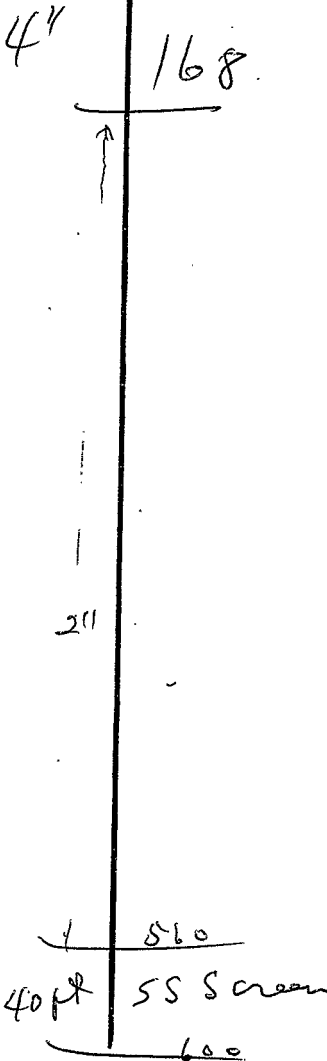


SECTION \_\_\_\_\_

Please indicate well location X.

**ADDITIONAL INFORMATION**

If more than one screen, show locations of each on sketch.