

LEFLORE

L73

7-10-74

MISSISSIPPI BOARD OF WATER COMMISSIONERS 416 North State Street Jackson, Mississippi 39201

CODED

WATER WELL DRILLERS LOG

7-10-74 date well completed

BUTANE GAS CO. OF GREENWOOD

Leflore

firm name

county well located

LANDOWNER:

description of formations encountered

from to

W.L. CRAIG

Clay Sand

0 20 20 97

Greenwood

(mailing address)

SAND + GRAVEL

97 124

WELL LOCATION:

Clay

124 134

sec. 22 T 19 N S R 1 E W 1/4 miles S of Greenwood (distance) (direction) (nearest town)

GRAVEL

134 142

Clay

142 254

SAND

254 307

Clay

307 355

WELL PURPOSE: (home, irrigation, municipal, industrial)

Home

SAND + SHALE

355 421

Rock

421 445

WELL COMPLETION DATA:

SAND + SHALE

445 455

Rock streaks

455 459

- (1) diameter (inches) 2 (2) total depth (feet) 776 (3) static water level (feet) 6 below top of ground. (4) casing Steel (material), 754 (depth) (size) If telescope see back. (5) screen 20 (length), 754 (depth to top) (size), Stainless (material) (6) pump 3/4 (HP), 10 (yield gpm) (7) electric log NU (yes or no) (organization running log) (8) how well bottom plugged Back Pressure Valve

Clay CODED

459 460

Rock

460 480

SANDY SHALE

480 490

SAND

490 505

Rock + SHALE

505 630

SANDY SHALE

630 671

SAND

671 684

SANDY SHALE

684 703

SAND + SHALE

703 714

SAND + SHALE STREAKS

714 735

SAND

735 750

HARD PACKED SAND

750 780

SHALE CLAY

780 790

RECEIVED


AUG - 8 1974

DRILLERS REMARKS:

MISS. Bd. OF WATER COMM.

If well telescopes please sketch and show depths.

GROUND LEVEL

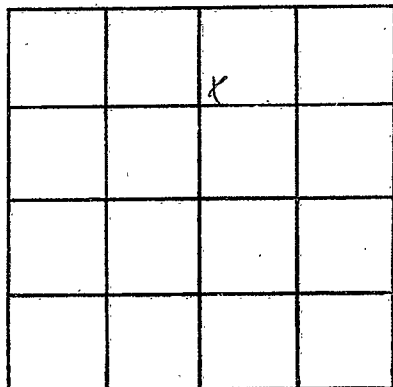

SECTION _____

Please indicate well location X.

ADDITIONAL INFORMATION

If more than one screen,
show locations of each on sketch.